

Marshall  
 D34  
 6-68

MISSISSIPPI  
 BOARD OF WATER COMMISSIONERS  
 416 North State Street  
 Jackson, Mississippi 39201  
 WATER WELL DRILLERS LOG

**CODED**

6-16-68 date well completed      Bob Smith Well Co. firm name      Marshall county well located

LANDOWNER: Crank  
Byhalia, Miss.  
 (mailing address)  
 WELL LOCATION:  
 sec. 23 T 2 N R. 5 E  
6 miles N of Byhalia  
 (distance) (direction) (nearest town)

description of formations encountered	from	to
<u>Top soil</u>	<u>0</u>	<u>20</u>
<u>Clay</u>	<u>20</u>	<u>40</u>
<u>gravel</u>	<u>40</u>	<u>90</u>
<u>Sand</u>	<u>90</u>	<u>138</u>

WELL PURPOSE: Home  
 (home, irrigation, municipal, industrial)

- WELL COMPLETION DATA:
- (1) diameter (inches) 4
  - (2) total depth (feet) 138'
  - (3) static water level (feet) 80 below top of ground.
  - (4) casing Plastic 138'  
 (material) (depth)  
 (size) if telescope see back.
  - (5) screen 20 118'  
 (length) (depth to top)  
4 Plastic  
 (size) (material)
  - (6) pump 1/2 5  
 (HP) (yield gpm)  
Electric  
 (type power)
  - (7) electric log No  
 (yes or no)

**CODED**


(8) how well bottom plugged plugged  
 (organization running log)

DRILLERS REMARKS: good drilling

UNITS 9-10-68  
 MISS. BOARD OF  
 WATER COM.

If well telescopes please sketch and show depths.

GROUND LEVEL

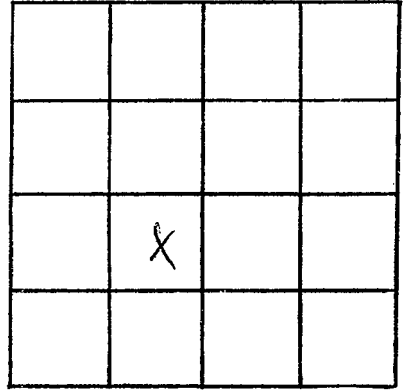

SECTION \_\_\_\_\_

Please indicate well location X.

ADDITIONAL INFORMATION

If more than one screen, show locations of each on sketch.