

Marshall
D 35
8-68

MISSISSIPPI
BOARD OF WATER COMMISSIONERS
416 North State Street
Jackson, Mississippi 39201

CODED

WATER WELL DRILLERS LOG

8/1 1968 Bob Smith Marshall
date well completed firm name county well located

LANDOWNER: Shelle

description of formations encountered	from	to
top soil	0	5
red clay	5	10
white clay	10	20
white sand	20	100

Byhalia Miss
(mailing address)

WELL LOCATION:
sec. 27 T. 2 N. R. 5 E.
3 miles east of Miller
(distance) (direction) (nearest town)

WELL PURPOSE: home
(home, irrigation, municipal, industrial)

WELL COMPLETION DATA:
(1) diameter (inches) 4
(2) total depth (feet) 100
(3) static water level (feet) 30 below top of ground.
(4) casing plastic 100
(material) (depth)


(size) If telescope see back.
(5) screen 20 80
(length) (depth to top)
4 plastic
(size) (material)

(6) pump 1/3 10
(HP) (yield gpm)
Elac
(type power)

(7) electric log no
(yes or no)
(organization running log)

(8) how well bottom plugged plugged


CODED

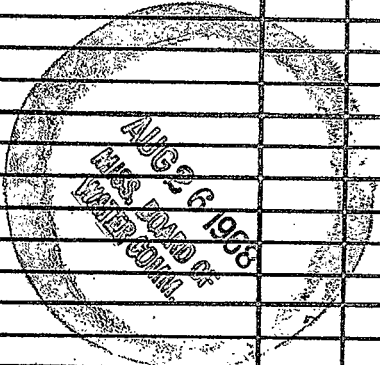

DRILLERS REMARKS:
Good drilling

If well telescopes please sketch and show depths.

GROUND LEVEL

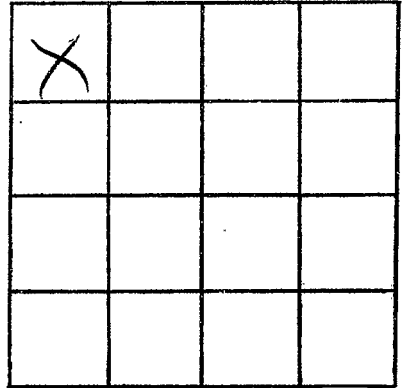

SECTION _____

Please indicate well location X.

ADDITIONAL INFORMATION

If more than one screen, show locations of each on sketch.