

Atkinson & Frost

MISSISSIPPI
BOARD OF WATER COMMISSIONERS
416 North State Street
Jackson, Mississippi 39201

CODED

WATER WELL DRILLERS LOG

Marshall

D36

7-18-68

7-18 1968
date well completed

Atkinson & Frost
firm name

Marshall
county well located

LANDOWNER:

description of formations encountered

from

to

(mailing address)

WELL LOCATION:

sec. 3 T 2 N R 5 E
6 miles Ne of Bohelia
(distance) (direction) (nearest town)

WELL PURPOSE:

(home, irrigation, municipal, industrial)

WELL COMPLETION DATA:

- (1) diameter (inches) 4 1/2
- (2) total depth (feet) 160
- (3) static water level (feet) 110 below above top of ground:
- (4) casing (material) (depth)

(size) If telescope see back.

- (5) screen 5 155
(length) (depth to top)

(size) (material)

- (6) pump 3/4 12
(HP) (yield gpm)

230
(type power)

- (7) electric log no
(yes or no)


(organization running log)

- (8) how well bottom plugged

DRILLERS REMARKS:

Bole COSSAI

CODED

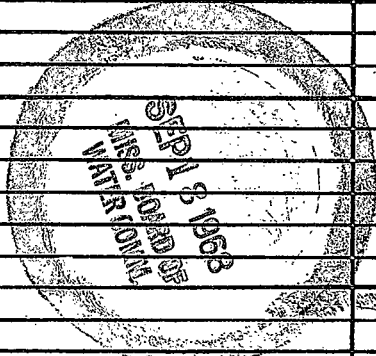

If well telescopes please sketch and show depths.

GROUND LEVEL

SECTION _____

Please indicate well location X.

ADDITIONAL INFORMATION

If more than one screen, show locations of each on sketch.