

**MARSHALL**  
**D 37**  
**11-8-72**

**MISSISSIPPI**  
**BOARD OF WATER COMMISSIONERS**  
 416 North State Street  
 Jackson, Mississippi 39201  
**WATER WELL DRILLERS LOG**

11 8 1972 Hicks Brothers Marshall  
 date well completed firm name county well located


LANDOWNER: <u>James Bowden</u>	description of formations encountered	from	to
<u>Byhalia Miss</u>	<u>Red sand</u>	<u>0</u>	<u>25</u>
(mailing address)	<u>White sand</u>	<u>35</u>	<u>135</u>
<b>WELL LOCATION:</b>			
sec <u>30</u> T <u>2</u> N R <u>5</u> E (distance) <u>2</u> miles <u>E</u> of <u>Byhalia</u> (direction) (nearest town)			
<b>WELL PURPOSE:</b> <u>Homes</u> (home, irrigation, municipal, industrial)			
<b>WELL COMPLETION DATA:</b>			
(1) diameter (inches) <u>4"</u>			
(2) total depth (feet) <u>135</u>			
(3) static water level (feet) <u>66</u> below above top of ground.			
(4) casing <u>Plastic</u> , <u>117</u> , (material) (depth) (size) if telescope see back.			
(5) screen <u>18'</u> , <u>118'</u> (length) (depth to top)			
<u>4"</u> , <u>Gravel</u> (size) (material)			
(6) pump <u>5</u> <u>50</u> (HP) (yield gpm)			
<u>220 FIRC</u> (type power)			
(7) electric log <u>NO</u> (yes or no)			
(organization running log)			
(8) how well bottom plugged <u>Cap</u>			
<b>DRILLERS REMARKS:</b>			

NOV 20 1972

MISS. Bd. of  
 WATER COMMISSIONERS

If well telescopes please sketch and show depths.

GROUND LEVEL

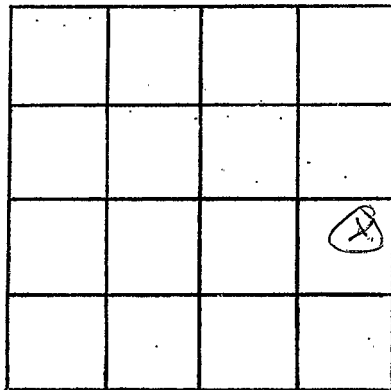

SECTION \_\_\_\_\_

Please indicate well location X.

ADDITIONAL INFORMATION

A series of horizontal lines for writing additional information.

If more than one screen, show locations of each on sketch.