

MARSHALL
D 38
2-2-73

MISSISSIPPI
 BOARD OF WATER COMMISSIONERS
 416 North State Street
 Jackson, Mississippi 39201

CODED

WATER WELL DRILLERS LOG

2-2-1973 date well completed Robert W. Wilson firm name Marshall county well located

LANDOWNER: Hicks Brothers
Holly Springs
MISS
 (mailing address)

description of formations encountered	from	to
red clay red sand gravel	0	20
red sand	20	60
white sand white clay	60	70
white sand	70	135
white sand, white clay	135	150
white clay white sand	150	165
white sand	165	195

WELL LOCATION:
 sec. 24 T 2 N R 5 E
 (S) (W)
 _____ miles _____ of _____
 (distance) (direction) (nearest town)

WELL PURPOSE:
 (home, irrigation, municipal, industrial)

WELL COMPLETION DATA:

- (1) diameter (inches) 4
- (2) total depth (feet) 190
- (3) static water level (feet) 100 below above top of ground.
- (4) casing _____, _____
 (material) (depth)
 _____ if telescope see back.
 (size)
- (5) screen 20, 170
 (length) (depth to top)
4, gravel packed
 (size) (material)
- (6) pump none
 (HP) (yield gpm)
electric
 (type power)
- (7) electric log _____
 (yes or no)

 (organization running log)
- (8) how well bottom plugged 4"
plastic cap


CODED

DRILLERS REMARKS:

MAR 10 1973

If well telescopes please sketch and show depths.

GROUND LEVEL

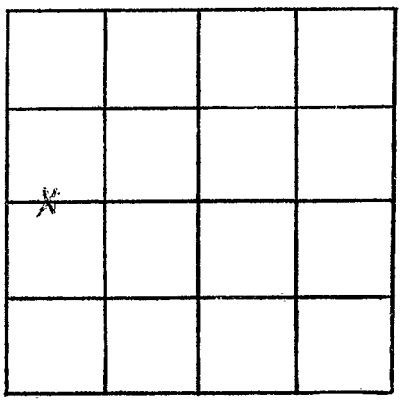

SECTION 24

Please indicate well location X.

ADDITIONAL INFORMATION

Lined area for additional information.

If more than one screen, show locations of each on sketch.