

MARSHALL

D 39

4-6-73

MISSISSIPPI BOARD OF WATER COMMISSIONERS
416 North State Street
Jackson, Mississippi 39201

CODING

WATER WELL DRILLERS LOG

4-6-1973 Penn Kent Drilling Marshall
date well completed firm name county well located

LANDOWNER:
Gene Mason
Byhalia, Miss
(mailing address)

description of formations encountered	from	to
<u>Clay</u>	<u>0</u>	<u>20</u>
<u>Sand</u>	<u>20</u>	<u>60</u>
<u>gravel</u>	<u>60</u>	<u>80</u>
<u>Sand</u>	<u>80</u>	<u>150</u>

WELL LOCATION:
sec. 27 T. 2 N. R. 5 E.
2 miles west of Byhalia
(distance) (direction) (nearest town)

WELL PURPOSE: Dwellings
(home, irrigation, municipal, industrial)

- WELL COMPLETION DATA:
- diameter (inches) 4"
 - total depth (feet) 150 feet
 - static water level (feet) 103 below above top of ground.
 - casing PVC, 150 feet
(material) (depth)
(size) if telescope see back.
 - screen 7ft, 143 feet
(length) (depth to top)
4", gravel wall
(size) (material)
 - pump 3/4, 14
(HP) (yield gpm)
(type power)
 - electric log Elect
(yes or no)
(organization running log)
 - how well bottom plugged 4" cap


CODING

DRILLERS REMARKS:

14 1973

If well telescopes please sketch and show depths.

GROUND LEVEL

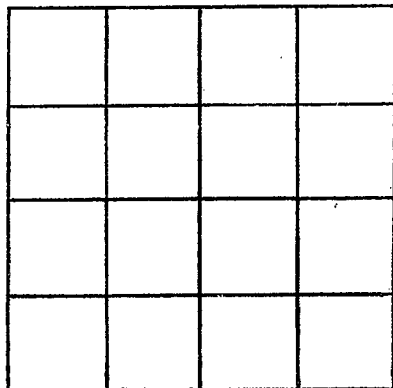

SECTION _____

Please indicate well location X.

ADDITIONAL INFORMATION

If more than one screen, show locations of each on sketch.