

D 41  
MARSHALL  
6-13-73

MISSISSIPPI  
BOARD OF WATER COMMISSIONERS  
416 North State Street  
Jackson, Mississippi 39201

**CODED**

WATER WELL DRILLERS LOG

6-13-1973 date well completed      Liba Bee Umb firm name      Marshall county well located

LANDOWNER: John Lopez

description of formations encountered	from	to

Route 2  
Sylvania, Miss  
(mailing address)

<u>Red Clay</u>	<u>0</u>	<u>15</u>
<u>Red Sand</u>	<u>15</u>	<u>45</u>
<u>Red Sand</u>	<u>45</u>	<u>90</u>
<u>White Sand</u>	<u>90</u>	<u>130</u>

WELL LOCATION:  
sec 34 T. 2 N. R. 5 E  
1 miles S of Sylvania  
(distance) (direction) (nearest town)

WELL PURPOSE: Home  
(home, irrigation, municipal, industrial)

WELL COMPLETION DATA:

- (1) diameter (inches) 4"
- (2) total depth (feet) 130'
- (3) static water level (feet) 96 below top of ground.
- (4) casing Plastic, 130,  
(material) (depth)
- (size) if telescope see back.
- (5) screen 4 ft  
(length) (depth to top)  
4" Gravel  
(size) (material)
- (6) pump 3/4 10 GPM  
(HP) (yield gpm)  
Electric, 230  
(type power)
- (7) electric log no  
(yes or no)

**CODED**

(organization running log)


(8) how well bottom plugged Cap

DRILLERS REMARKS:

AUG 20 1973

If well telescopes please sketch and show depths.

GROUND LEVEL

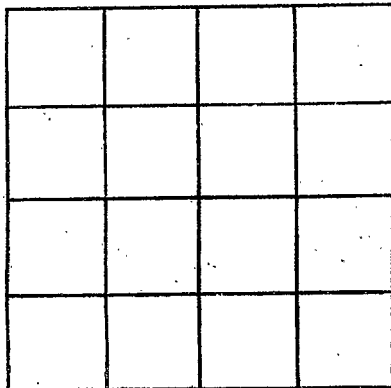

SECTION \_\_\_\_\_

Please indicate well location X.

ADDITIONAL INFORMATION

If more than one screen,  
show locations of each on sketch.