

MARSHALL  
D42  
8-27-73

MISSISSIPPI  
BOARD OF WATER COMMISSIONERS  
416 North State Street  
Jackson, Mississippi 39201

SEP 14 1973  
CODED  
MISS. Bd. WATER COMM.

WATER WELL DRILLERS LOG

8-27-1973 date well completed  
Boblin's Sew. Wells firm name  
Marshall county well located

LANDOWNER: Clorrie Bussell  
% Leo Alexander - Rt 1  
Box 224, Sylva, Miss.  
(mailing address)

description of formations encountered	from	to
<u>Red Sand &amp; Clay</u>	<u>0</u>	<u>15</u>
<u>Red Sand &amp; white sand</u>	<u>15</u>	<u>30</u>
<u>white sand</u>	<u>30</u>	<u>90</u>

WELL LOCATION:  
sec. 18 T 2 N R 5 E  
3 miles S of Sylva  
(distance) (direction) (nearest town)

WELL PURPOSE: Home  
(home, irrigation, municipal, industrial)


- WELL COMPLETION DATA:
- (1) diameter (inches) 4 1/2
  - (2) total depth (feet) 90
  - (3) static water level (feet) 20 below top of ground.
  - (4) casing Plastic, 90  
(material) (depth)
  - (size) if telescope see back.
  - (5) screen 5 1/4, 85  
(length) (depth to top)
  - 4 in, stapel  
(size) (material)
  - (6) pump 3/4, 10  
(HP) (yield gpm)
  - Electric 220  
(type power)
  - (7) electric log no  
(yes or no)
  - (organization running log)
  - (8) how well bottom plugged Cap

CODED

DRILLERS REMARKS:

If well telescopes please  
sketch and show depths.

GROUND LEVEL

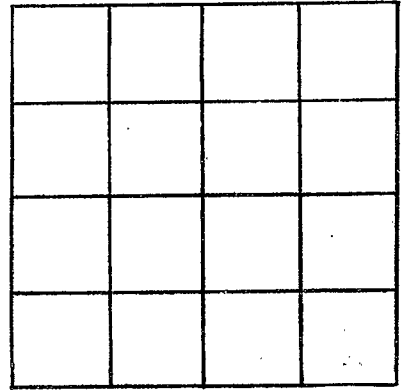

SECTION \_\_\_\_\_

Please indicate well location X.

ADDITIONAL INFORMATION

If more than one screen,  
show locations of each on sketch.