

MARSHALL

D 43

7-22-73

MISSISSIPPI
 BOARD OF WATER COMMISSIONERS
 416 North State Street
 Jackson, Mississippi 39201

CODED

WATER WELL DRILLERS LOG

7-22-1973
date well completed

Bob Smith
firm name

Marshall
county well located

LANDOWNER:

Aug L. Hood

Bylatia - miss
(mailing address)

description of formations encountered

Clay Silt

from

to

10

white clay

10

40

Red sand

40

70

white sand

70

100

WELL LOCATION:

sec. 36 T 2 N R 5 E
 (S) (W)
1 miles East of Bylatia
 (distance) (direction) (nearest town)

WELL PURPOSE:

None
(home, irrigation, municipal, industrial)

WELL COMPLETION DATA:

- (1) diameter (inches) 4
- (2) total depth (feet) 100
- (3) static water level (feet) 63 below above top of ground.
- (4) casing Plastic 100
(material) (depth)
- (size) if telescope see back.
- (5) screen 20 80
(length) (depth to top)
- (size) 4 (material) Plastic
- (6) pump 1/3 10
(HP) (yield gpm)
- (type power) Free
- (7) electric log no
(yes or no)

CODED

(organization running log)

(8) how well bottom plugged plugged


DRILLERS REMARKS:

SEP 27 1973

MISS. BI
WATER C.

If well telescopes, please sketch and show depths.

GROUND LEVEL

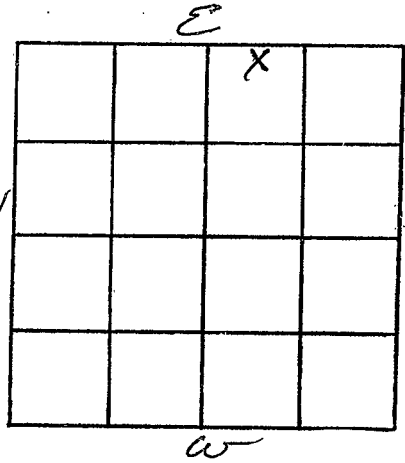

SECTION 36

Please indicate well location X.

ADDITIONAL INFORMATION

If more than one screen, show locations of each on sketch.