

MARSHALL
D 44
10-17-73

MISSISSIPPI
 BOARD OF WATER COMMISSIONERS **CODED**
 416 North State Street
 Jackson, Mississippi 39201

WATER WELL DRILLERS LOG

Oct 17 1973 Earl Jones Well Co. Marshall
 date well completed firm name county well located

LANDOWNER:
Willard King
Byhalia Miss. RT.
 (mailing address)

WELL LOCATION:
 sec. 23 T. 2 S. R. 5 E. W.
2 1/2 miles NW. of Byhalia
 (distance) (direction) (nearest town)

WELL PURPOSE: Home
 (home, irrigation, municipal, industrial)

- WELL COMPLETION DATA:**
- (1) diameter (inches) 4"
 - (2) total depth (feet) 96
 - (3) static water level (feet) 80 below above top of ground.
 - (4) casing plastic (material), 90' (depth)
4" if telescope see back.
 (size)
 - (5) screen 6' (length), 90. (depth to top)
4" (size), plastic gravel (material)
 - (6) pump 1 (HP), 22 (yield gpm)
Electric (type power)
 - (7) electric log no (yes or no)
- (organization running log)

description of formations encountered	from	to
Topsoil & clay	0	18
sand	18	55
gravel	55	58
clay	58	64
sand	64	96

CODED

(8) how well bottom plugged plastic cap


DRILLERS REMARKS:

NOV 7 1973

MISS. BLD. OF
 WATER COMM.

If well telescopes please sketch and show depths.

GROUND LEVEL

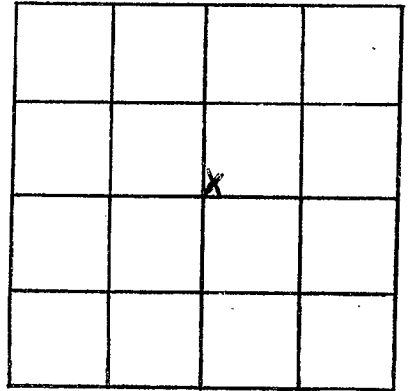

SECTION 23

Please indicate well location X.

ADDITIONAL INFORMATION

If more than one screen,
show locations of each on sketch.