

MARSHALL
D 45
8-12-73

MISSISSIPPI
 BOARD OF WATER COMMISSIONERS
 416 North State Street
 Jackson, Mississippi 39201

CODED

WATER WELL DRILLERS LOG

8-12-73 date well completed Click Bros. Well Co. firm name Marshall county well located

LANDOWNER: James
 Fountain - Rt 2
 Box 15A, Bynalia, Miss.
 (mailing address)

description of formations encountered	from	to
Red Clay	0	15
Red Sand	15	90
White Sand	90	135
White Sand & Clay	135	165
White Clay	165	180
White Sand	180	210

WELL LOCATION:
 sec. 34 T 2 N R 5 E
 3/4 miles NW of Bynalia
 (distance) (direction) (nearest town)

WELL PURPOSE: Some
 (home, irrigation, municipal, industrial)

WELL COMPLETION DATA:

(1) diameter (inches) 4 in.

(2) total depth (feet) 210

(3) static water level (feet) 60 below top of ground.

(4) casing Plastic, 210 (material) (depth)

if telescope see back.
 (size)

(5) screen 12, 198 (length) (depth to top)
 1/2 in. Brass (size) (material)

(6) pump 3/4, 10 (HP) (yield gpm)
 Electric, 220 (type power)

(7) electric log No (yes or no)

(organization running log)

(8) how well bottom plugged Cap

CODED


DRILLERS REMARKS:

DEC 26 1973

MISSISSIPPI
 BOARD OF WATER COMMISSIONERS

If well telescopes please sketch and show depths.

GROUND LEVEL

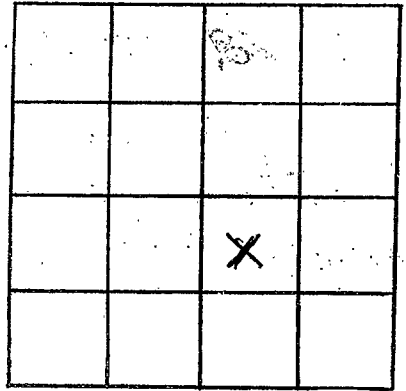

SECTION 34

Please indicate well location X.

ADDITIONAL INFORMATION

If more than one screen,
show locations of each on sketch.