

MARSHALL
D46
11-14-73

MISSISSIPPI
 BOARD OF WATER COMMISSIONERS **CODED**
 416 North State Street
 Jackson, Mississippi 39201

WATER WELL DRILLERS LOG

11-14-73 date well completed Shiaba Well firm name Marshall county well located

LANDOWNER: Curtis Lee
Jones - Route 1 Box 3395
Sylva, Miss
 (mailing address)

description of formations encountered	from to	
	feet	feet
<u>Red Sand</u>	<u>0</u>	<u>45</u>
<u>white sand</u>	<u>45</u>	<u>120</u>
<u>white sand & clay</u>	<u>120</u>	<u>135</u>
<u>white sand</u>	<u>0</u>	<u>135</u>

WELL LOCATION:
 sec. 12 T. 2 N. R. 5 E.
6 miles SE of Sylva
 (distance) (direction) (nearest town)

WELL PURPOSE: Home
 (home, irrigation, municipal, industrial)

- WELL COMPLETION DATA:
- (1) diameter (inches) 4 inch.
 - (2) total depth (feet) 150
 - (3) static water level (feet) 75 below top of ground.
 - (4) casing Plastic, 150
 (material) (depth)
 - _____ if telescope see back.
 (size)
 - (5) screen 4ft. 146
 (length) (depth to top)
4in. Gravel
 (size) (material)
 - (6) pump 3/4 10 M.P.M.
 (HP) (yield gpm)
Electric 220
 (type power)
 - (7) electric log no
 (yes or no)
 - _____ (organization running log)
 - (8) how well bottom plugged Cap

CODED


DEC 26 1973

DRILLERS REMARKS:

MISSISSIPPI
 BOARD OF WATER COMMISSIONERS
 LICENSE NO. _____

If well telescopes please sketch and show depths.

GROUND LEVEL

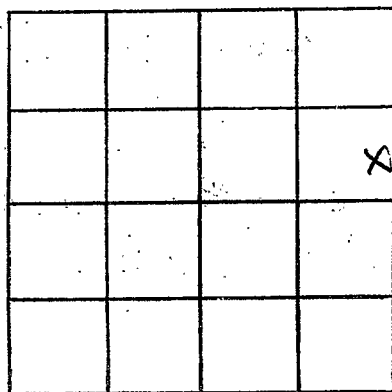

SECTION 12

Please indicate well location X.

ADDITIONAL INFORMATION

If more than one screen, show locations of each on sketch.