

MARSHALL

D 49

8-29-73

MISSISSIPPI BOARD OF WATER COMMISSIONERS
416 North State Street
Jackson, Mississippi 39201

CODED

WATER WELL DRILLERS LOG

8-29-73
date well completed

Bob Smith
firm name

Marshall
county well located

LANDOWNER:

Ralph Sabin

Byhalia - Miss.
(mailing address)

description of formations encountered

Top soil

from 0' to 5'

Red clay

5' 40'

Sand

40' 100'

WELL LOCATION:

sec. 27 T-2 N R-5 E
3 miles SW of Byhalia
(distance) (direction) (nearest town)

WELL PURPOSE:

Home
(home, irrigation, municipal, industrial)

CODED

WELL COMPLETION DATA:

- (1) diameter (inches) 4
- (2) total depth (feet) 100
- (3) static water level (feet) 45 below top of ground.
- (4) casing Plastic 100
(material) (depth)
- (size) If telescope see back.
- (5) screen 30 80
(length) (depth to top)
- 4 Plastic
(size) (material)
- (6) pump 1/2 10
(HP) (yield gpm)
- Electric
(type power)
- (7) electric log 20
(yes or no)

(organization running log)

(8) how well bottom plugged plugged

DRILLERS REMARKS:


RECEIVED

III - 5 1974

MISS. BD. OF WATER COMM

If well telescopes please sketch and show depths.

GROUND LEVEL

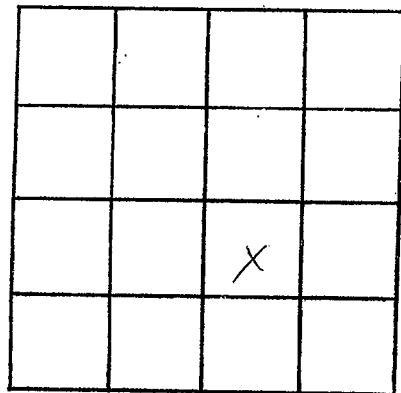

SECTION 27

Please indicate well location X.

ADDITIONAL INFORMATION

If more than one screen,
show locations of each on sketch.