

MARSHALL

#58, D 50

6-8-74

MISSISSIPPI BOARD OF WATER COMMISSIONERS
416 North State Street
Jackson, Mississippi 39201

WATER WELL DRILLERS LOG

CODED
C. Marshall
E. J. [unclear]

6-8-74
date well completed

1974 W.G. Mason
firm name

county well located

LANDOWNER:

Kernon Gates
RFD, Callierville Tenn
(mailing address)

description of formations encountered

description of formations encountered	from	to
Clay dirt	0	4
Blue clay	4	20
white sand	20	65

WELL LOCATION:

sec. 3 T. 1 N. R. 5 E.
2 1/2 miles SW of Barton
(distance) (direction) (nearest town)

WELL PURPOSE: Home
(home, irrigation, municipal, industrial)

CODED

WELL COMPLETION DATA:

- (1) diameter (inches) 4"
- (2) total depth (feet) 65'
- (3) static water level (feet) 6' below top of ground
- (4) casing Plastic, 55' (material) (depth)
4" (size) if telescope see back.
- (5) screen 10' 55' (length) (depth to top)
4" Plastic (size) (material)
- (6) pump 1/3 7 (HP) (yield gpm)
- (7) electric log No (yes or no)

(organization running log)

(8) how well bottom plugged caps

RECORDED
INDEXED


DEC 27 1974

MISS. BD. OF WATER COMMISSIONERS

DRILLERS REMARKS:

If well telescopes please sketch and show depths.

GROUND LEVEL

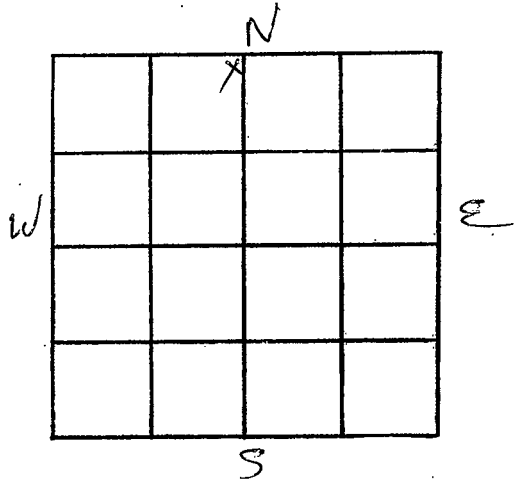

SECTION 3

Please indicate well location X.

ADDITIONAL INFORMATION

If more than one screen, show locations of each on sketch.