

MARSHALL  
 D51  
 4-16-75

MISSISSIPPI  
 BOARD OF WATER COMMISSIONERS  
 416 North State Street  
 Jackson, Mississippi 39201

WATER WELL DRILLERS LOG

CODED

4-16-19 Rob Schlops Well Co. Marshall  
 date well completed firm name county well located

LANDOWNER: George

description of formations encountered

from to

Plantinga - P.O. Box 76  
Sylva, Miss. 38611  
 (mailing address)

<u>Red Clay + gravel</u>	<u>0</u>	<u>15</u>
<u>Gravel</u>	<u>15</u>	<u>60</u>
<u>Gravel &amp; white sand</u>	<u>60</u>	<u>90</u>
<u>White sand &amp; clay</u>	<u>90</u>	<u>105</u>
<u>White sand</u>	<u>105</u>	<u>140</u>

WELL LOCATION:

sec. 14 T 2 N R 5 E  
 (S) (W)  
3 miles E of Sylva ?  
 (distance) (direction) (nearest town)

WELL PURPOSE: Home  
 (home, irrigation, municipal, industrial)

WELL COMPLETION DATA:

- (1) diameter (inches) 4 1/2
- (2) total depth (feet) 140
- (3) static water level (feet) 110 below above top of ground.
- (4) casing Plastic, 140  
 (material) (depth)

\_\_\_\_\_ If telescope see back.  
 (size)

- (5) screen 4 1/2, 136  
 (length) (depth to top)  
4 1/2, Gravel  
 (size) (material)

- (6) pump 1/2, 0  
 (HP) (yield gpm)

Electric 230  
 (type power)

- (7) electric log no  
 (yes or no)

\_\_\_\_\_ (organization running log)

- (8) how well bottom plugged Cap


DRILLERS REMARKS:

RECEIVED  
 MISSISSIPPI  
 BOARD OF WATER COMMISSIONERS

MAY 23 1975

If well telescopes please sketch and show depths.

GROUND LEVEL

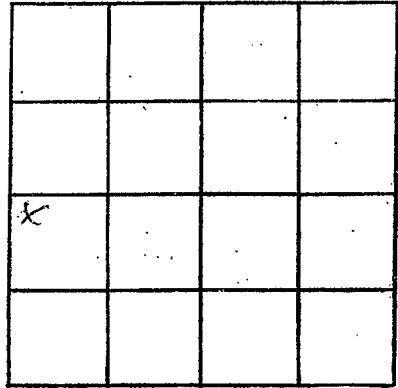

SECTION 16

Please indicate well location X.

ADDITIONAL INFORMATION

If more than one screen, show locations of each on sketch.