


**MARSHALL**  
**D 52**  
**9-17-75**

MISSISSIPPI  
 BOARD OF WATER COMMISSIONERS  
 416 North State Street  
 Jackson, Mississippi 39201

**CODED**

**WATER WELL DRILLERS LOG**


4-17 1975 *Shinks Well Co.* *Marshall*  
 date well completed firm name county well located

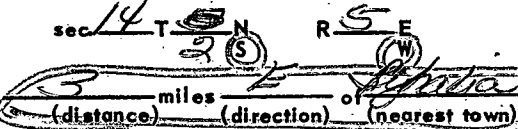LANDOWNER:	description of formations encountered	from	to
<i>George Fletcher - P.O. Box 393, Bygdalia, Miss. (mailing address)</i>	<i>Red Clay</i>	<i>0</i>	<i>15</i>
	<i>Red Sand</i>	<i>15</i>	<i>45</i>
	<i>Brn &amp; white clay</i>	<i>45</i>	<i>75</i>
	<i>white clay &amp; sand</i>	<i>75</i>	<i>90</i>
	<i>white sand</i>	<i>90</i>	<i>157</i>
<b>WELL LOCATION:</b> sec <i>14</i> T <i>2</i> N R <i>5</i> E  (distance) (direction) (nearest town)			
<b>WELL PURPOSE:</b> <i>Home</i> (home, irrigation, municipal, industrial)			
<b>WELL COMPLETION DATA:</b> (1) diameter (inches) <i>4 1/2</i>			
(2) total depth (feet) <i>157</i>			
(3) static water level (feet) <i>110</i> below top of ground.			
(4) casing <i>Plastic</i> , <i>157</i> (material) (depth)			
(size) if telescope see back.			
(5) screen <i>4 ft</i> , <i>153</i> (length) (depth to top)			
<i>4 1/2</i> , <i>Gravel</i> (size) (material)			
(6) pump <i>1/2</i> , <i>10</i> (HP) (yield gpm)			
<i>Electric 230</i> (type power)			
(7) electric log <i>no</i> (yes or no)			
(organization running log)			
(8) how well bottom plugged <i>Cap</i>			
<b>DRILLERS REMARKS:</b>			

RECEIVED  
 MAY 23 1975

If well telescopes please sketch and show depths.

GROUND LEVEL

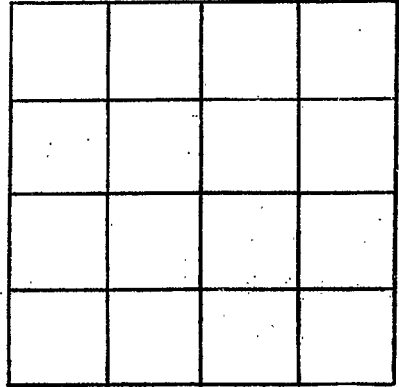

SECTION \_\_\_\_\_

Please indicate well location X.

ADDITIONAL INFORMATION

If more than one screen, show locations of each on sketch.