

Marshall
 D 54
 4-16-75

MISSISSIPPI
 BOARD OF WATER COMMISSIONERS
 416 North State Street
 Jackson, Mississippi 39201

WATER WELL DRILLERS LOG

CODED

4-16-1975 date well completed
 W.A. Mason Water Well Contractors firm name
 Marshall county well located

LANDOWNER:
 Mrs. Agnes Black
 RFD, Poyhalia, Miss.
 (mailing address)

description of formations encountered	from	to
Clay Silt	0	9
gravel	9	20
crushed sand	20	130

WELL LOCATION:
 sec. 14 T. 2 N. R. 5 E. 15E
 2 3/4 miles N of Poyhalia
 (distance) (direction) (nearest town)

WELL PURPOSE: Home
 (home, irrigation, municipal, industrial)

- WELL COMPLETION DATA:
- (1) diameter (inches) 4"
 - (2) total depth (feet) 130'
 - (3) static water level (feet) 78' below top of ground.
 - (4) casing Plastic, 170' (material) (depth)
 4" if telescope see back. (size)
 - (5) screen 10' 170' (length) (depth to top)
 4" Plastic (size) (material)
 - (6) pump 1/2 5 (HP) (yield gpm)
 electric (type power)
 - (7) electric log No (yes or no)

(organization running log)


(8) how well bottom plugged
 cap on screen

DRILLERS REMARKS:

RECEIVED
 JUL 01 1975

If well telescopes please sketch and show depths.

GROUND LEVEL

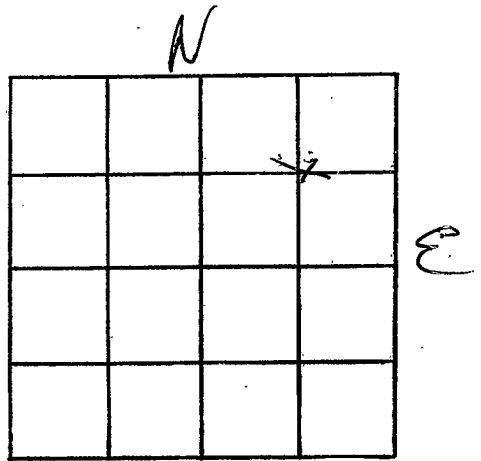

3
SECTION 14

Please indicate well location X.

ADDITIONAL INFORMATION

If more than one screen, show locations of each on sketch.