

Marshall
D 55
4-18-75

MISSISSIPPI
BOARD OF WATER COMMISSIONERS
416 North State Street
Jackson, Mississippi 39201

CODED

WATER WELL DRILLERS LOG

4-18-75 date well completed
W.A. Mazon Water Well Contractor firm name
Marshall county well located

LANDOWNER:
Ralph Holyfield
P.O. Box 1000
Byhalia, Miss.
(mailing address)

description of formations encountered	from	to
clay silt	0	10
yellow clay	10	23
gravel	23	45
white sand	45	150
CODED		

WELL LOCATION:
sec. 14 T. 2 N. R. 5 E. 15E
23/4 miles N of Byhalia
(distance) (direction) (nearest town)

WELL PURPOSE: Home
(home, irrigation, municipal, industrial)

- WELL COMPLETION DATA:
- (1) diameter (inches) 4 1/2
 - (2) total depth (feet) 150'
 - (3) static water level (feet) 90' below top of ground.
 - (4) casing Plastic, 135'
(material) (depth)
4" if telescope see back.
(size)
 - (5) screen 15', 135'
(length) (depth to top)
4" Plastic
(size) (material)
 - (6) pump 1/2 HP, 7 (yield gpm)
electric
(type power)
 - (7) electric log NO
(yes or no)
- (organization running log)


(8) how well bottom plugged
Cap on screen

DRILLERS REMARKS:

RECEIVED
JUL 01 1975

If well telescopes please sketch and show depths.

GROUND LEVEL

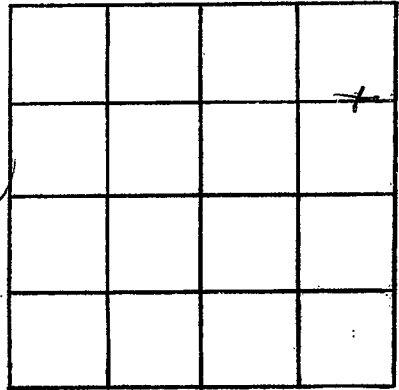

SECTION S 14

Please indicate well location X.

ADDITIONAL INFORMATION

If more than one screen, show locations of each on sketch.