

Marshall
D 56
4-11-75

MISSISSIPPI
BOARD OF WATER COMMISSIONERS
416 North State Street
Jackson, Mississippi 39201

CODED

WATER WELL DRILLERS LOG

4-11-1975 date well completed
W.A. Mason Water Well Contractor firm name
Marshall county well located


LANDOWNER:	description of fomations encountered	from	to
Mrs. Elaine Owens RFD, Byhalia Miss. (mailing address)			
WELL LOCATION:	Red sand	8	30
sec. 14 T. 7 N. R. 5 E. SE 2 1/4 miles N of Byhalia (distance) (direction) (nearest town)	white sand	30	160
WELL PURPOSE: Home (home, irrigation, municipal, industrial)			
WELL COMPLETION DATA:			
(1) diameter (inches) 4 1/2	CODED		
(2) total depth (feet) 160'			
(3) static water level (feet) 100' below top of ground.			
(4) casing Plastic 150' (material) (depth) 4 1/2" If telescope see back. (size)			
(5) screen 10' 150' (length) (depth to top) 4 1/2" Plastic (size) (material)			
(6) pump 1/2 5 (HP) (yield gpm) electric (type power)			
(7) electric log NO (yes or no)			
(organization running log)			
(8) how well bottom plugged Cap on screen			
DRILLERS REMARKS:			

RECEIVED

APR 01 1975

If well telescopes please sketch and show depths.

GROUND LEVEL

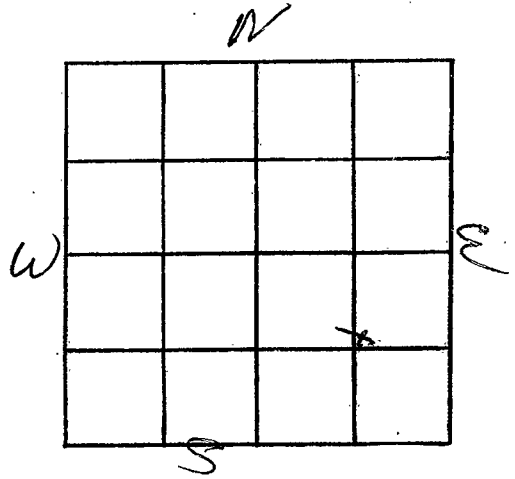

SECTION 14

Please indicate well location X.

ADDITIONAL INFORMATION

If more than one screen, show locations of each on sketch.