

Marshall  
D 57  
4-8-75

MISSISSIPPI  
BOARD OF WATER COMMISSIONERS  
416 North State Street  
Jackson, Mississippi 39201

WATER WELL DRILLERS LOG

CODED

4-8-1975 date well completed  
W. R. Mason firm name  
Marshall county well located


LANDOWNER:	description of formations encountered	from	to
Mrs. C. E. Armstrong RFD- Bayhalia Miss. (mailing address)			
WELL LOCATION: sec. 14 T. 2 N. R. 5 E 2 miles N of Bayhalia (distance) (direction) (nearest town)	Red clay	15	25
WELL PURPOSE: Home (home, irrigation, municipal, industrial)	red sand	25	50
WELL COMPLETION DATA: (1) diameter (inches) 4"	gravel	50	60
(2) total depth (feet) 163'	unCODED sand	60	163
(3) static water level (feet) 114' below top of ground.			
(4) casing Plastic, 153' (material) (depth) 4" (size) if telescope see back.			
(5) screen 18', 153' (length) (depth to top) 4" Plastic (size) (material)			
(6) pump 3/4 HP, 5 (HP) (yield gpm) Electric (type power)			
(7) electric log No (yes or no)			
(8) how well bottom plugged Cap on screen			
DRILLERS REMARKS:			

RECEIVED  
APR 11 1975

MAR 01 1975

If well telescopes please sketch and show depths.

GROUND LEVEL

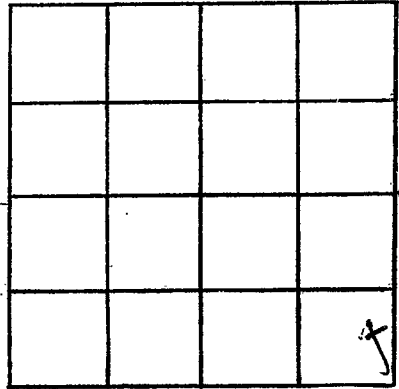

SECTION 14

Please indicate well location X.

ADDITIONAL INFORMATION

If more than one screen, show locations of each on sketch.