

Marshall  
D 58  
4-7-75

MISSISSIPPI  
BOARD OF WATER COMMISSIONERS  
416 North State Street  
Jackson, Mississippi 39201

CODED

WATER WELL DRILLERS LOG

4-7-1975 W.A. Mason Water Well Constructors Marshall  
date well completed firm name county well located

LANDOWNER:	description of formations encountered	from	to
C.W. Brown Sr. RFD. Byhalia Miss. (mailing address)			
WELL LOCATION:	red sand	12	20
sec. 14 T 2 N R 5 E 156 2 1/2 miles N of Byhalia (distance) (direction) (nearest town)	Clay	20	30
WELL PURPOSE: Home (home, irrigation, municipal, industrial)	gravel	30	34
WELL COMPLETION DATA:	white sand	34	139
(1) diameter (inches) 4"			
(2) total depth (feet) 139'			
(3) static water level (feet) 85' below top of ground.			
(4) casing Plastic 129' (material) (depth)			
4" if telescope see back. (size)			
(5) screen 10' 129' (length) (depth to top)			
4" Plastic (size) (material)			
(6) pump 1/2 8 (HP) (yield gpm)			
electric (type power)			
(7) electric log NO (yes or no)			
(organization running log)			
(8) how well bottom plugged cap on screen			
DRILLERS REMARKS:			


CODED

RECEIVED  
MAY 01 1975

MAY 01 1975

If well telescopes please sketch and show depths.

GROUND LEVEL

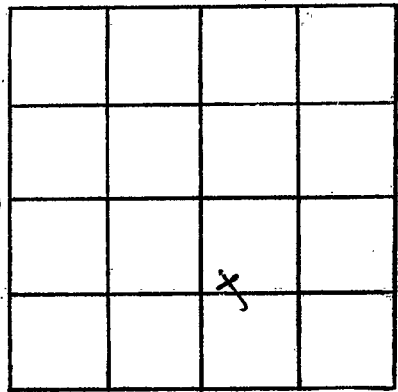

SECTION 14

Please indicate well location X.

ADDITIONAL INFORMATION

If more than one screen, show locations of each on sketch.