

Marshall  
 D 59  
 5-8-75

MISSISSIPPI  
 BOARD OF WATER COMMISSIONERS  
 416 North State Street  
 Jackson, Mississippi 39201

CODED

WATER WELL DRILLERS LOG

5-8-1975 date well completed  
 W. G. Mason firm name  
 Marshall county well located

LANDOWNER: Mr. Pat Frazier  
RFD, Bynolia Miss  
 (mailing address)

WELL LOCATION:  
 sec. 14 T. 2 N. R. 5 E. <sup>15E</sup>  
2 3/4 miles N of Bynolia  
 (distance) (direction) (nearest town)

description of formations encountered	from	to
<u>clay silt</u>	<u>70</u>	<u>20</u>
<u>Red clay</u>	<u>20</u>	<u>40</u>
<u>white sand</u>	<u>40</u>	<u>130</u>

WELL PURPOSE: Home  
 (home, irrigation, municipal, industrial)

WELL COMPLETION DATA:

(1) diameter (inches) 4"

(2) total depth (feet) 130'

(3) static water level (feet) 66' below top of ground

(4) casing Plastic, 120'  
 (material) (depth)  
4" if telescope see back.  
 (size)

(5) screen 10', 120'  
 (length) (depth to top)  
4", Plastic  
 (size) (material)

(6) pump 1/2 5  
 (HP) (yield gpm)  
electric  
 (type power)

(7) electric log No  
 (yes or no)

(organization running log)

CODED


(8) how well bottom plugged  
Cap on screen

RECEIVED  
 RECEIVED  
 JUL 01 1975

DRILLERS REMARKS:

If well telescopes please sketch and show depths.

GROUND LEVEL

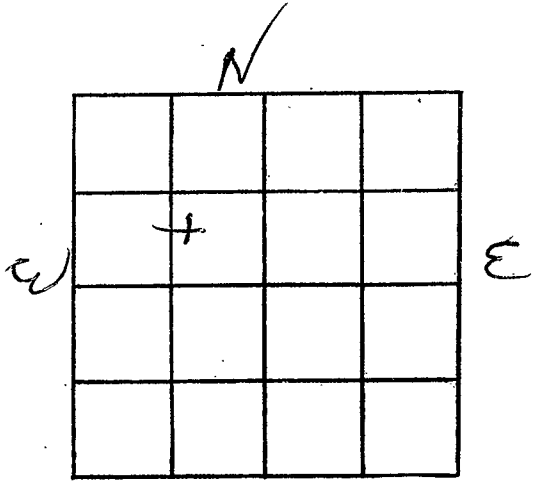

3 SECTION 148

Please indicate well location X.

ADDITIONAL INFORMATION

If more than one screen, show locations of each on sketch.