

MISSISSIPPI DEPARTMENT OF NATURAL RESOURCES

Bureau of Land and Water Resources

Southport Mall

P.O. Box 10631

Jackson, Mississippi 39209

WATER WELL DRILLERS LOG

Marshall
D 61
Log # 30
14841

Coded

5/5

1994

Layne-Central

Marshall

date well completed

firm name

county well located

LANDOWNER:

City of Byhalia

P. O. Box 412

Byhalia, Mississippi 38611

(mailing address)

description of formations encountered

from

to

See Attached Log

WELL LOCATION:

sec. 36 T N
 Township 2W S

R. 5 ~~XX~~
 W

_____ miles _____ of _____
 (distance) (direction) (nearest town)

WELL PURPOSE: Municipal
 (home, irrigation, municipal, industrial)

WELL COMPLETION DATA:

- (1) diameter (inches) 16"
- (2) total depth (feet) 1604'
- (3) static water level (feet) 26' below ~~above~~ top of ground.
- (4) casing Steel, 1525'
 (material) (depth)

_____ if telescope see back.
 (size)

- (5) screen 71', 1529'
 (length) (depth to top)
10" SST
 (size) (material)

- (6) pump 60 400
 (HP) (yield gpm)
3/60/460
 (type power)

- (7) electric log Yes
 (yes or no)

Layne
 (organization running log)

- (8) how well bottom plugged Cement
& BPV

DRILLERS REMARKS:

~~Handwritten mark~~

~~Handwritten mark~~


RECEIVED

JUN 27 1994

Dept. of Environmental Quality
 Office of Land & Water Resources

If well telescopes please
sketch and show depths.

GROUND LEVEL

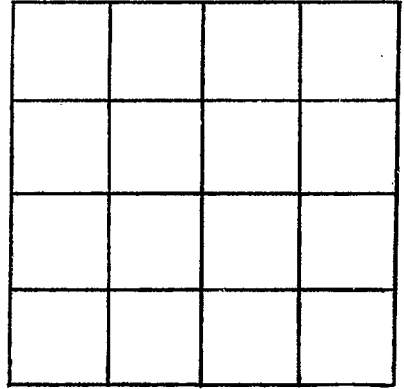

SECTION _____

Please indicate well location X.

ADDITIONAL INFORMATION

If more than one screen,
show locations of each on sketch.