

**MISSISSIPPI DEPARTMENT OF ENVIRONMENTAL
QUALITY**

Office of Land and Water Resources

P. O. Box 10631
Jackson, MS 39289-0631
WATER WELL DRILLERS LOG

COUNTY WELL LOCATED <u>Marshall</u>	
WELL NUMBER <u>D-71</u>	CODED
DATE WELL COMPLETED <u>8-1-03</u>	

PERMIT NUMBER
NAME OF DRILLING FIRM <u>Mason water wells</u>

NAME & MAILING ADDRESS OF LANDOWNER <u>Morior Myers 522 Bubba Taylor rd.</u>			
<u>Bylolia ms 38611</u>			
Latitude: Longitude:			
WELL LOCATION. SEC <u>24</u>	TOWNSHIP <u>2 N</u>	RANGE <u>5 E</u>	
DISTANCE <u>1 1/4</u> Miles	DIRECTION <u>E</u>	NEAREST TOWN <u> Hwy 309 N</u>	
OTHER LANDMARK			
WELL PURPOSE: <input checked="" type="checkbox"/> Home Irrigation, <input type="checkbox"/> Municipal, <input type="checkbox"/> Industrial, <input type="checkbox"/> Fish Pond, etc.			

PUMP DATA		
PUMP TYPE (Circle One): <input checked="" type="checkbox"/> Submersible, <input type="checkbox"/> Turbine, <input type="checkbox"/> Jet <input type="checkbox"/> Flowing Well, Other (Describe)		
POWER TYPE (Circle One): <input checked="" type="checkbox"/> Electric, <input type="checkbox"/> Tractor, <input type="checkbox"/> Diesel, <input type="checkbox"/> Gasoline, <input type="checkbox"/> Butane, Other (Describe) <u>H/P 3/4</u>		
DESCRIPTION OF FORMATIONS ENCOUNTERED	FROM	TO
<u>dirt</u>	<u>0</u>	<u>10</u>
<u>gravel</u>	<u>10</u>	<u>30</u>
<u>wt clay</u>	<u>30</u>	<u>60</u>
<u>wt sand</u>	<u>60</u>	<u>98</u>
<u>wt clay</u>	<u>98</u>	<u>100</u>
<u>wt sand</u>	<u>100</u>	<u>164</u>
<u>wt clay</u>	<u>164</u>	
RECEIVED		
OCT 09 2003		
BY: OLWR		
Top of Lap Pipe or Reduction in Casing		
FEET	IF TELESCOPED OR MORE THAN ONE SCREEN: USE BACK PAGE	

WELL DATA

Well Depth <u>164'</u>	Casing Diameter (In.) <u>4"</u>	Casing Length (Ft.) <u>154</u>
Type of Casing <u>pvc</u>	Hole Depth <u>164</u>	Depth to Static Water Level <u>100'</u>
TYPE OF COMPLETION: (Circle One or More): <input checked="" type="checkbox"/> Gravel Packed, <input type="checkbox"/> Underreamed, <input type="checkbox"/> Telescoped, <input type="checkbox"/> Natural Development, <input type="checkbox"/> Open Hole, <input type="checkbox"/> Other (Describe)		
WELL GROUTED TO A DEPTH OF <u>50</u> FEET Type Grout (circle one): <input checked="" type="checkbox"/> Cement, <input type="checkbox"/> Bentonite, or Mix		

SCREEN DATA

Diameter - Inches <u>4</u>	Length - Feet <u>10</u>	Slot Size - Inches <u>#10</u>
Screen Type <u>pvc</u>	Depth to Bottom - Feet <u>164</u>	

I certify that the well was drilled, constructed and completed in accordance with all applicable Requirements of the Mississippi Department of Environmental Quality and/or the Mississippi Department of Health regulations and state laws.


Jones W. Mozur 0-620
Signature of Licensed Driller and License No.

10-2-03
Date

Additional Information Required On Back

If well telescopes please sketch and show depths.

GROUND LEVEL

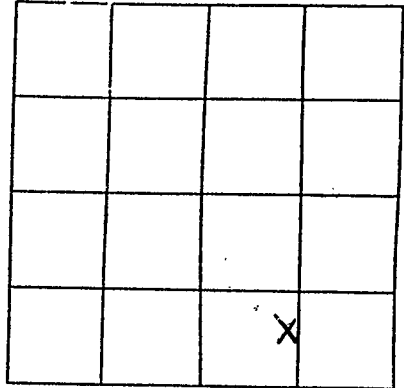

SECTION 24

Please indicate well location X.

Pump Capacity (GPM)	No. of Stages	Setting Depth
<u>12</u>	<u>11</u>	<u>120</u> FT.

PUMP TEST

Well yielded _____ GPM with
a drawdown of _____ ft.
after _____ hours of pumping

LOG DATA

TYPE OF LOG RUN (Circle One): No Log Run,
Electric, Gamma Ray, Density, Sonic, Neutron,
Other (Describe) _____

Name of Organization Running Log _____

GEOLOGIC DATA (Office Use Only)

Surface Elev.	Geologic Unit	Unit Thickness	Depth to Top
Subs. SWL	Date	Analysis	Aquifer Test

Driller's Remarks

3 1/2 hp - GWS 6 bladder

If more than one screen,
show location of each on sketch.