| • | · | | For Office Use Only: | | | |
|--------|--|---------------------------------------|--------------------------------|--|--|--|
| ſ | County: MArshall 093 Well Driller R | eport and Well Log | Aquifer: | | | |
| | Nississippi Departme | nt of Environmental Quality | Well #: $D - 84$ | | | |
| | Office of Land | and Water Resources Box 10631 | L. S. Elevation: | | | |
| | Jackson, Jackson, | MS 39289-0631 | E-log #: | | | |
| | | 1)961-5210 54-6938 (fax) | | | | |
| . / | Mason Watur Wello, JJC (601)3 State Law requires that this report be prepared by the | | h the Department within | | | |
| | State Law requires that this report be prepared by a | Wel | I Location | | | |
| · - [| Well Owner Information | | - Longitude: <u>- 43,373</u> " | | | |
| | Owner Name George Lee | Latitude: $37 \cdot 57$ | Longhude | | | |
| | Mailing Address: LOT 3 woodview | Method of Lat/Long (circle c | one): Conventional Survey, | | | |
| | | USGS quad, Hand-hel | d GPS, Survey-grade GPS | | | |
| | 2 4 12 405 3861 | NE 1/ NJKU 1/ Sec 15 | -V. Twn 25 Rng Sw | | | |
| | Byhalia Ms 38611 City State Zip Code | NW SW Distance Direction | of <u>old</u> itm 78. | | | |
| | Telephone No. (901) 387 - 7018 | <u> </u> | of <u>old they to</u> | | | |
| | | fell Data | | | | |
| | Duklia Su | oply Irrigation Fish Cultu | re Other: | | | |
| | Purpose of Well (circle one) Home Industrial Public Supply Irrigation Fish Culture Other: Date well drilling started: Date well drilling completed: | | | | | |
| | Date well drilling started: | Date well drilling completed | <u> </u> | | | |
| | | | | | | |
| 1911 | If flowing, method of flow regulation: ValveO Static Water Level: feet above or celow (circle | - and surface Date meas | ured: | | | |
| · · | Method of Measurement (circle one) steel tape electr | ic tape air line other: | Strive Iweight | | | |
| ì | Method of Measurement (circle one) steel tape electr Hole depth: <u>105'</u> Well depth: <u>105'</u> | Well grouted to a dept | h of <u>10</u> feet | | | |
| • | | | | | | |
| | Type of grout (circle one): Cement Bentonite | Mix | ····· | | | |
| | Casing length: <u>95'</u> feet Casing diameter: | | sing: | | | |
| 1 | Screen-length: 10 feet Screen diameter: | finches Type of scr | een: <u>puc</u> | | | |
| • | OID inches Setting depth: | From 95 feet to | | | | |
| | Screen slot size: | Underreamed Telescoped | Open hole Natural Development | | | |
| i , | Type of completion (circle all applicable): | | | | | |
| | Other (describe) | | describe on back of page | | | |
| • | Top of lap pipe or reduction in casing: <u>NA</u> feet. If telescoped or more than one screen, describe on back of pa | | | | | |
| | Logs run (circle all applicable): No log run Electric Gamma Ray Density Sonic Neutron Other: | | | | | |
| • . | | | | | | |
| • | Name of organization running log(s): I certify that the well was drilled, constructed, and completed in accord | ance with all applicable requirements | 01 (IIe 11131315)pp 2 0 p-1 | | | |
| • • • | Environmental Quality and/or the Mississippi Department of Heating to | 52121011 | | | | |
| | Jones Wy Moser 0-620 | Charter 2 | Mas | | | |
| . • | Jones Wy Massing O Coo | Signatu | re of Water Well Contractor | | | |
| | Print Name of Water Well Contractor and License No. | | RECEIVED | | | |
| 2 | if well telescopes please sketch below and show depths. | | MAR 2 8 2005 | | | |
| • • | | Avera Maria | | | | |
| · · | | | BY: OLWF | | | |
| | | | | | | |

. ...

: .†


. If well telescopes please sketch below and show depths.



| | | _ |
|---------------------------------------|------|-----|
| Description of Formations Encountered | From | To |
| | 0 | 30 |
| | 30 | 40 |
| white Chy | 40 | 105 |
| white soud | | |
| | | |
| | | |
| | | 1 |
| | | 1 |
| | | |
| | | + |
| | | |
| | | |
| | | 1 |
| | | |
| | | |
| | | _ |
| | | _ |
| | | |
| | | |
| | | |

D-84

If more than one screen, show location of each on sketch

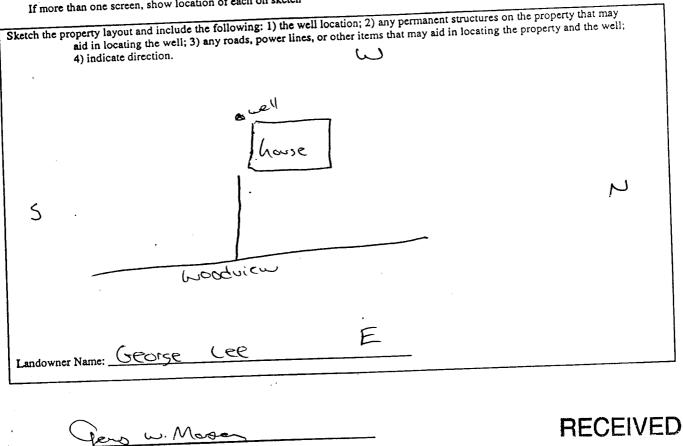

Signature of Water Well Contractor

MAR 2 8 2005 BY: OLWR

| County: MArshall | STATE WELL REPORT Part 2 Pump Installer's Completion Report | For Office Use Only | y: |
|--|--|---|--------|
| ermit #: M | ississippi Department of Environmental Qualit Office of Land and Water Resources | | |
| Driller: Jones W. Mason | P.O. Box 10631 Jackson, MS 39289-0631 | Well #: <u>D-84</u> | |
| Date completed: 3-2-05 | (601)961-5210 (601)354-6938 (fax) | Elevation: | |
| installation of nump. | mp installer in detail and filed with the Depa | rtment within 30 days of the Well Location | |
| Well Owner Information | 24.54 | Well Location 486Longitude: 089 43 | 377 |
| wher Name: George Lee | | cle one): Conventional Survey, | |
| lailing Address: LOT 3 wood | USGS quad. | (Hand-held GPS) Survey-grade (| GPS |
| Byhalia MS City State | | 25 Twn 25 Rng 5 | ω |
| City State | Zip Code · Distance Direc | ion [·] Nearest Town | |
| elephone No. (901) 387 - 7018 | <u>I'Z Miles N</u> | of Old Hwy 78 | |
| Pump Type | | Power Type Circle one | |
| Circle one | | Gasoline Engine Natural | l Gas |
| ur Lift | Iomersione Dieter Zugen | Hand Tractor | PTO |
| | irbine Electric motor | Other (specify): | |
| centritugal (1012) | Horse Power Rating of | Motor:3/ 4 | |
| Date Pump Installed: <u>3-2-05</u> | | 80 feet | |
| Date Pump Installed: I 2 | llons Per Minute Number of Stages: | - | |
| Rated Pump Capacity:GaGa | 1 | | |
| Pump Test Data | Method | of Measuring Water Level Circle one | |
| Date Well Tested: 3-2-05 | | ie Measuring Line Steel Ta | ape |
| | ow Land Surface Other (specify): | ing I weight. | |
| amping . | ow Land Surface | | feet |
| | 1 | ured shut in head:A GPM_with a drawdown | - |
| I cat I uniphilg tutter | llons Per Minute Well yielded | 0 | |
| Duration of Pump Test (minimum 4 hours): | <u><u><u></u><u></u><u></u><u></u><u></u><u></u><u></u><u></u><u></u><u></u><u></u><u></u><u></u><u></u><u></u><u></u><u></u><u></u></u></u> | after <u>34</u> hours of pur | inping |
| | | | |
| HEREBY CERTIFY that the above statement | is are true to the best of my knowledge. | Moory | |
| Print Name of Pump Installer and License No. | (if applicable) | ump Installer | |

-

MAR 2 8 2005 BY: OLWR

State Street of the