	and the UL . Descent and	Well Log	For Office Use Only:
County: MArshall 093	Well Driller Report and Well Log		Aquifer:
Permit #:	Mississippi Department of Enviro Office of Land and Water F	nmental Quality	Well#:
Driller: Jones w. Mason	P.O. Box 10631		L. S. Elevation:
Date drilling completed: 2-25-05	Jackson, MS 39289-0 (601)961-5210	631	E-log #:
Mason water Willo,	(601)354-6938 (fa:		
Moson Water Witter,	report be prepared by the driller in	detail and filed with	the Department within
TO dove of completion of our		Well	Location
Well Owner Into	mation	34.54.321	" Longitude <u>089 . 43 . 32</u>
Owner Name George Lee	Latitude	<u> </u>	19
Mailing Address: LOT 9	Method	of Lat/Long (circle on	e): Conventional Survey,
wanning room	110	GS quad, Hand-held	GPS Survey-grade GPS
	MS 30611 NE	NO 1/2 Sec 15	Twn JS Rng Sw
Byhalia City	Zin Code Sin/	Siv	Norman Town
Telephone No. (901) 387-7		Miles <u>N</u> .	of Oct they To.
Telephone No. ((C))	Well Data		
	I I I I I I I I I I I I I I I I I I I	gation Fish Culture	Other:
Purpose of Well (circle one) Home	Industrial Public Supply Irrig	wine completed!	2-25-05
Date well drilling started:	- <u>35- 05</u> Date well d	ning completee.	
If flowing method of flow regulation	on: Valve <u>NA</u> Other (descri	oe)	2-2-05-
11 nowing,	feet above or below (circle one) land s	surface Date measu	red:
Static Water Level:	e) steel tape electric tape	air line other: _	
Method of Measurement (circle on	e) steel tape electric tape Well depth: (15 ¹ W	/ell-grouted to a depth	of <u>10</u> feet
Hole depth: 115	Vell depth:	0.1. Brager	
Type of grout (circle one): Cem			
	T in	ches Type of casin	$lg: - \rho \cup C$
Casing length: <u>105</u> reet		ches Type of scree	en:
Screen length: 10 feet	Screen diameter:	AS fast to	115feet
	a wine deaths From		
Exampletion (circle all app	licable): Gravel packed Underrear	ned Telescoped	Open noie - Matural Bereio
, [Out an (describe)		
	sing: <u>PA</u> feet. If telesc	oned or more than o	ne screen, describe on back o
Top of lap pipe or reduction in ca	sing: <u>P/+</u> teet. If telest		ron Other:
in a line line hasher	No log run) Electric Gamma Ray I	Density Sonic Neur	
Logs run (circle all application running log	(s):	1 ble securicamente A	f the Mississippi Department of
Name of organization running ion	(S): ructed, and completed in accordance with all	applicable requirements o I state laws.	
 Ferraria (199) Statistical Control (199) 	Log the stment of the tegulations and		
			J. Man-

20**2**1

•

RECEIVED MAR 2 8 2005 BY: OLWR

Ň

с. н.

÷,

If well telescopes please sketch below and show depths.

Ground Level

S. Salaria


Description of Formations Encountered	From	To
Clev dirt.	0	125
white sad	<u> </u>	60
white clay	Ges	25
white soud.	- 25	115
		╉╼╌╍╸
		+
		+
		I.

D-85

BY: OLWR

2

If more than one screen, show location of each on sketch

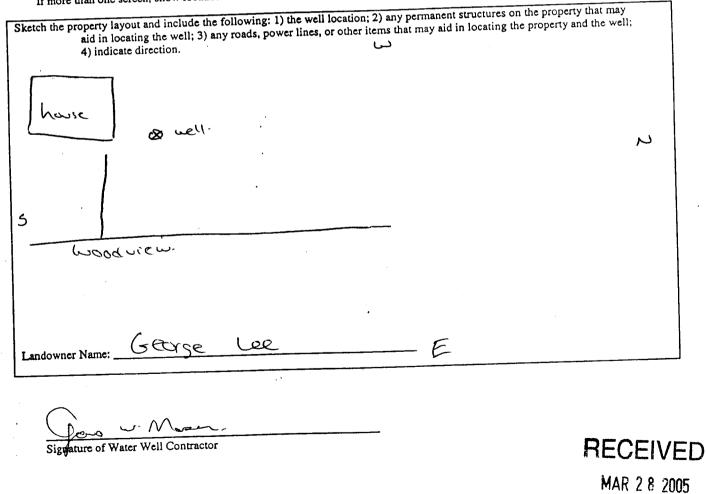

New John Constant Const	n ang an ang ang ang ang ang ang ang ang	• • •	
۰ ۶			•
		LL REPORT	
County: MArshall	Pumn Installer's	Completion Report	For Office Use Only:
Permit #:	Mississippi Department Office of Land a	t of Environmental Quality nd Water Resources	Aquifer:
Driller: Jones U. Mason	P.O. B	ox 10631 S 39289-0631	Well #: D-85
	(601)9	961-5210	Elevation:
Date completed: 3-2-05		4-6938 (fax)	
This report should be prepared by	the pump installer in detail	and filed with the Departm	ent within 30 days of the
installation of pump. Well Owner Inform		W	ell Location
Owner Name: George Le		Latitude: 34, 54-321	_Longitude: 089. 43.321
Owner Name:		Method of LavLong (circle o	
Mailing Address: <u>LOT 9</u>			nd-held GPS Survey-grade GPS
wooduie			15 Twn 25 Rng 5w
Byhalic Me	ie Zip Code		
•			Nearest Town
Telephone No. (99) 387-70	18	112 Miles N	or old Hay 78-
Telephone No. ()			
Pump Type			Power Type Circle onc
Circle one			line Engine Natural Gas
Air Lift Jet	Submersible	Dieser Engine	Tracios PTO
Bucket Piston	Turbine	Electric Motor Han	d
-	Flowing Well	Windmill Oth	er (specify):
Cenunugai	•	Horse Power Rating of Mor	tor: <u>314</u>
Other (specify):		Setting Depth:(00 ⁻ feet
Date Pump Installed:			11
Rated Pump Capacity:()	Gallons Per Minute	Number of Stages:	
		Method of	Measuring Water Level
Pump Test D			Circle one
Date Well Tested: 3-2-05	·		Acasuring Line Steel Tape
Static Water Level (A): 75	Feet Below Land Surface	Other (specify):	is lweight
Pumping Water Level (B): NA	Feet Below Land Surface		
	Feet Below Land Surface	For flowing well, measured	d shut in head: $\ \ \ \ \ \ \ \ \ \ \ \ \ \ \ \ \ \ \$
	-		GPM with a drawdown of
Test Pumping Rate:	Gallons Per Minute		$r _ \rightarrow 4$ hours of pumping
Duration of Pump Test (minimum 4 ho	ours): 24 hours		nour or program
I HEREBY CERTIFY that the above :	interments are true to the best	of my knowledge.	
		Com w.	Moon.
Print Name of Pump Installer and Lice	ase No. (if applicable)	Signature of Pum	ip Installer
	LISC IND. (II application)	and the second	

.....

กธ MAR 2 8 2005 BY: OLW R

...