

# State Well Report

## Part 1 - Driller's Log

Mississippi Department of Environmental Quality  
Office of Land and Water Resources  
P.O. Box 10631  
Jackson, MS 39289-0631  
(601)961-5210  
(601)354-6938 (fax)

County: Marshall  
Permit #: \_\_\_\_\_  
Driller: James W. Major  
Date drilling completed: 12-4-05

For Office Use Only:

Aquifer: \_\_\_\_\_  
Well #: D-95  
L. S. Elevation: \_\_\_\_\_  
E-log #: \_\_\_\_\_

**State Law requires that this report be prepared by the license holder responsible for the work and filed with the Department at the above address within 30 days of completion of drilling of the well or borehole.**

Information on Well Owner <i>(Landowner if borehole is not for a water well)</i>	Well or Borehole Location
Owner Name: <u>Charles Anderson</u>	Latitude: <u>34.54.353"</u> Longitude: <u>89.42.953"</u>
Mailing Address: <u>11 Sandy ridge</u>	Method of Lat/Long (circle one): <u>21</u> Conventional Survey, <u>57</u>
<u>Byhalia</u> MS <u>38611</u>	USGS quad, Hand-held GPS, Survey-grade GPS
City State Zip Code	<u>NW</u> 1/4 <u>SE</u> 1/4 Sec <u>15</u> Twn <u>25</u> Rng <u>5w</u>
Telephone No. <u>(423) 280-6877</u>	<u>5w</u> Distance Direction Nearest Town <u>3 3/4</u> Miles <u>sw</u> of <u>Barton</u>
Well / Borehole Data	
Date drilling started: <u>12-4-05</u> Date drilling completed: <u>12-4-05</u> Hole depth: <u>245'</u> Hole diameter: <u>8"</u>	
Location of the source of any surface water used for drilling: <u>NA</u>	
Method of dosing and volume of Chlorine used in drilling and development: <u>NA</u>	
Logs run (circle all applicable) <u>No log run</u> <input type="checkbox"/> Electric <input type="checkbox"/> Gamma Ray <input type="checkbox"/> Density <input type="checkbox"/> Sonic <input type="checkbox"/> Neutron <input type="checkbox"/> Other: _____	
Name of organization running log(s): <u>NA</u>	
Purpose of borehole (check one): Water Well <input checked="" type="checkbox"/> Geotechnical/Geological Investigation _____ Ground Source Heat Pump _____	
Seismic Survey _____ Other (describe) _____	
<b><i>If drilling is not related to water well construction, skip the remainder of this block</i></b>	
Purpose of Well (check one): Home <input checked="" type="checkbox"/> Industrial _____ Public Supply _____ Irrigation _____ Fish Culture _____ Other: _____	
If a flowing well, method of flow regulation: Valve <u>NA</u> Other (describe) _____	
Static Water Level: <u>90</u> feet above or <u>below</u> (circle one) land surface Date measured: <u>12-13-05</u>	
Method of Measurement (circle one) steel tape electric tape air line other: <u>string weight</u>	
Well depth: <u>245</u> Well grouted to a depth of <u>10</u> feet Type of grout (circle one): Neat Cement <u>Bentonite</u> Mix	
Casing length: <u>235</u> feet Casing diameter: <u>4</u> inches Type of casing: <u>pvc</u>	
Screen length: <u>10</u> feet Screen diameter: <u>4</u> inches Type of screen: <u>pvc</u>	
Screen slot size: <u>.070</u> inches Setting depth: From <u>235</u> feet to <u>245</u> feet	
Type of completion (circle all applicable): <u>Gravel packed</u> Underreamed Telescoped Open hole Natural Development	
Other (describe): <u>NA</u>	
Top of lap pipe or reduction in casing: <u>NA</u> feet <b><i>If telescoped or more than one screen, describe on next page</i></b>	

Form: OLWR-SWR-1A

RECEIVED

JAN 06 2006


BY: OLWR

The sketch below only required for water wells

Description of formations encountered must be provided for all wells and boreholes, unless specifically exempted by regulations

If well telescopes, show depths on sketch.


Ground Level →

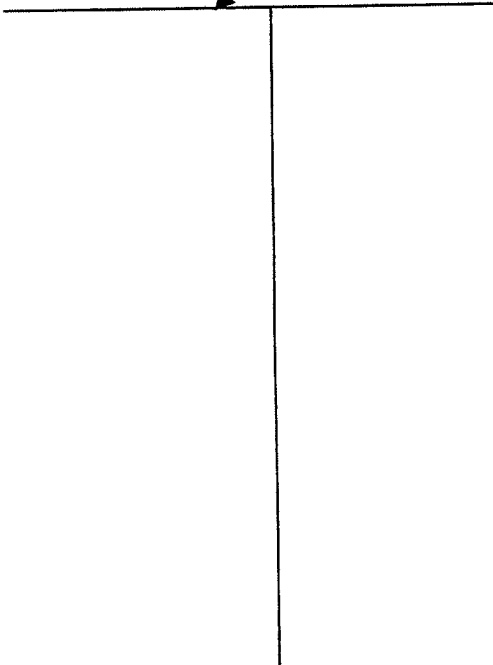

Description of Formations Encountered	From (depth)	To (depth)
clay dirt.	Ground Level	40
Red Sand	40	60
white sand.	60	90
white clay	90	110
white sand	110	120
white clay	120	140
white sand.	140	145
white clay	145	160
white sand	160	170
white clay	170	200
white sand	200	210
white clay	210	220
white sand.	220	245

If more than one screen, show location of each on sketch

Sketch the property layout and include the following: 1) the well location; 2) any permanent structures on the property that may aid in locating the well; 3) any roads, power lines, or other items that may aid in locating the property and the well; 4) a north arrow.

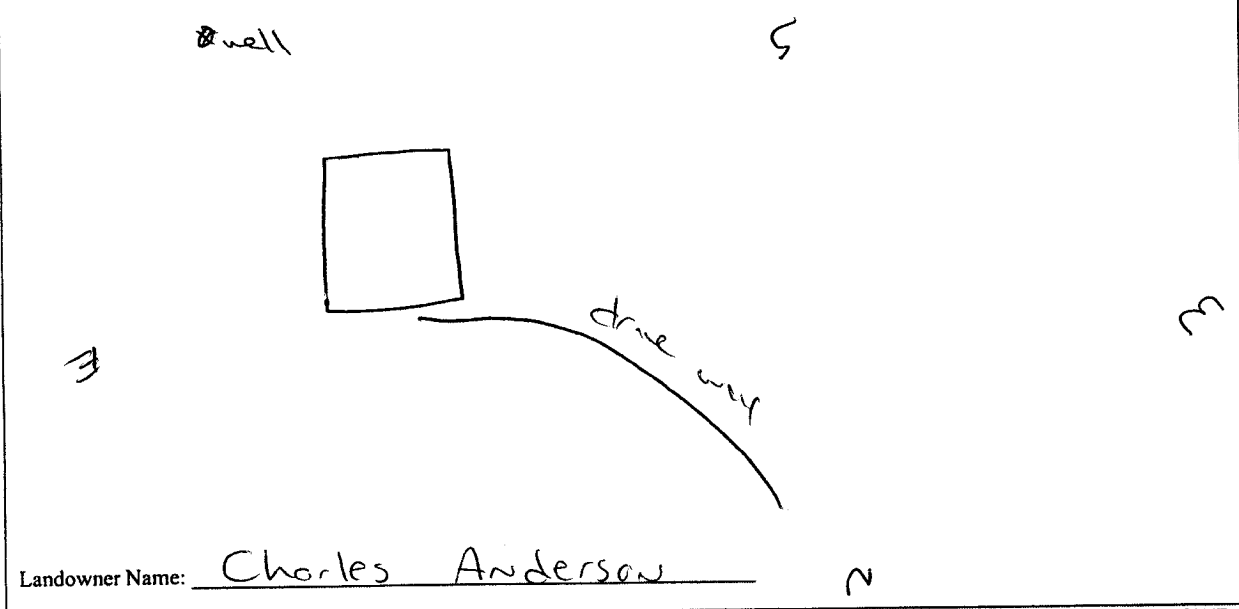

Form: OLWR-SWR-1A

I certify that the well/borehole was drilled, constructed, and completed in accordance with all applicable requirements of the Mississippi Department of Environmental Quality and the Mississippi Department of Health regulations, if applicable, and state laws.

Jones W. Masou 0-620 1-1-06  
Print Name of Responsible Licensee and License No. Date

[Signature]  
Signature of Licensee

RECEIVED  
JAN 06 2006  
BY: OLWR

# STATE WELL REPORT

## Part 2

**Pump Installer's Completion Report**  
 Mississippi Department of Environmental Quality  
 Office of Land and Water Resources  
 P.O. Box 10631  
 Jackson, MS 39289-0631  
 (601)961-5210  
 (601)354-6938 (fax)

County: Marshall  
 Permit #: \_\_\_\_\_  
 Driller: Jones W. Mason  
 Date completed: 12-13-05  
*Copy information from block on Part 1*

**For Office Use Only:**

Aquifer: \_\_\_\_\_  
 Well #: D-95  
 Elevation: \_\_\_\_\_

*This part of the report must be completed by a licensed water well contractor or a licensed pump installer. A copy of Part 1 of the report must be attached and both parts filed with the Department at the above address within 30 days of well completion.*

Well Owner Information	Well Location
Owner Name: <u>Charles Anderson</u>	Latitude: <u>34.54.353</u> Longitude: <u>89.42.953</u>
Mailing Address: <u>11 Sandy ridge</u>	Method of Lat/Long (check one): Conventional Survey _____
<u>Byholia</u> <u>MS</u> <u>38611</u>	USGS quad _____ Hand-held GPS <input checked="" type="checkbox"/> Survey-grade GPS _____
City State Zip Code	NW 1/4 SE 1/4 Sec <u>15</u> T <u>25</u> R <u>5w</u>
Telephone No. <u>(423) 280-6877</u>	Distance Direction Nearest Town
	<u>3.14</u> Miles <u>SW</u> of <u>Barton</u>

Pump Type Circle one	Power Type Circle one
Air Lift      Jet <u>Submersible</u>	Diesel Engine      Gasoline Engine      Natural Gas
Bucket      Piston      Turbine	<u>Electric Motor</u> Hand      Tractor PTO
Centrifugal      Rotary      Flowing Well	Windmill      Other (specify): _____
Other (specify): _____	Horse Power Rating of Motor: <u>1 1/2</u>
Date Pump Installed: <u>12-13-05</u>	Setting Depth: <u>120'</u> feet
Rated Pump Capacity: <u>20</u> Gallons Per Minute	Number of Stages: <u>14</u>

Pump Test Data	Method of Measuring Water Level Circle one
Date Well Tested: <u>12-13-05</u>	Air Line      Electric Measuring Line      Steel Tape
Static Water Level (A): <u>90</u> Feet Below Land Surface	Other (specify): <u>String / weight</u>
Pumping Water Level (B): <u>NA</u> Feet Below Land Surface	For flowing well, measured shut in head: <u>NA</u> feet
Drawdown [(B) - (A)]: <u>NA</u> Feet Below Land Surface	Well yielded <u>20</u> GPM with a drawdown of
Test Pumping Rate: <u>20</u> Gallons Per Minute	<u>NA</u> feet after <u>24</u> hours of pumping
Duration of Pump Test (minimum 4 hours): <u>24</u> hours	

I HEREBY CERTIFY that the above statements are true to the best of my knowledge.

Jones W. Mason      Jones W. Mason  
 Print Name of Pump Installer and License No. (if applicable)      Signature of Pump Installer

Form: OLWR-SWR-1B

RECEIVED

JAN 06 2006

BY: OLWR