		State Well Report	For Office Use Only:
	County: Morshall	Part 1 - Driller's Log	
ĺ	County: 107 State	Mississippi Department of Environmental Quality	Aquifer:
	Permit #:	Office of Land and Water Resources	Well #: <u>D-97</u>
		P.O. Box 10631	
	Driller: Jones W. Moson	Jackson, MS 39289-0631	L. S. Elevation:
	Date drilling completed: 4- 3-06	(601)961-5210	
	Date drilling completed:	(601)354-6938 (fax)	E-log #:

 $\mathbf{f}_{2}$ 

State Law requires that this report be prepared by the license holder responsible for the work and filed with the Department at the above address within 30 days of completion of drilling of the well or borehole.

Department at the above address within 50 ulys of comp	Well or Borehole Location		
Information on Well Owner			
(Landowner if borehole is not for a water well)	Latitude: <u>34.54.531</u> " Longitude: <u>87.43.038</u> " <b>22</b>		
· .	Latitude: 7 - 7 - 7 - 20 Longitude: - 7 - 72		
Owner Name_ (SCORGE LEC	Method of Lat/Long (circle one): Conventional Survey,		
-	Method of Lat/Long (circle one): Conventional Survey,		
Mailing Address: LOT 14			
Maining Address.	USGS quad, Hand-held GPS, Survey-grade GPS		
Scudy ridge	15/ 25. JW		
	NE 15 Sw 1/2 Sec 15 - Twn 25 Rng 5w		
Byholic M5 38611 City State Zip Code	1		
Citric IIIS Store	Distance Direction Nearest Town		
City State Zip Code	Distance Direction Nearest Town <u>312</u> Miles <u>5</u> of <u>Borton</u>		
Telephone No. (101) 387-7018			
	L. D. D. d.		
Well / Bore			
Date drilling started: 4-3-06 Date drilling completed: 4-3-0	Land Hole diameter: 6314		
Date drilling started. 4-3-06 Date drilling completed: 4-3-0	Hole depth: 100 Hole diameter.		
	N.4		
Location of the source of any surface water used for drilling and deve Method of dosing and volume of Chlorine used in drilling and deve	elopment: :/A		
Method of dosing and volume of Chlorine used in change			
Logs run (circle all applicable): No log run Electric Gamma Ray	Density Sonic Neutron Other:		
Logs run (circle all applicable): No log run Electric Ganana Ru			
Name of organization running log(S):			
	In sight Investigation Ground Source Heat Pump		
Purpose of borehole (check one): Water Well $\iota$ Geotechnical/Geo	Nogical Investigation Ground Source from the transf		
Seismic Survey Other (describ	(e)		
Scismic SurveyOther (describ If drilling is not related to water well construction	ion, skip the remainder of this block		
Purpose of Well (check one): Home Industrial Public Supp	ly Irrigation Fish Culture Other:		
Purpose of wen (check one). Theme			
If a flowing well, method of flow regulation: ValveA	Other (describe)		
If a flowing well, method of now regulation. Vary			
Static Water Level:fcet above of below (circle one	and surface Date measured: 4-3-06		
Static Water Level: leel above of telewidenete one	,		
Method of Measurement (circle one) steel tape electric tap	re airline other. String I weight		
Method of Measurement (circle one) steel tape electric af			
Well depth: 130 Well grouted to a depth of 10 feet Ty	ne of grout (circle one): Neat Cement (Bentonite) Mix		
Well depth: 30 Well grouted to a depth of reet is	pe of grout (chere one). How comment		
Casing length: 130 feet Casing diameter: 4 inches Type of casing: $\rho v c$			
Casing length: 1 20 feet Casing diameter:	inches Type of casing.		
Screen length: 10 feet Screen diameter: 4	inches Type of screen:OUC		
Screen lengui:leec			
(NID) inches Setting depth; From	feet to 130 feet		
Screen slot size: 010 inches Setting depth: From 130 feet to 130 feet			
Type of completion (circle all applicable): Gravel packed Underreamed Telescoped Open hole Natural Development			
Type of completion (circle all applicable). Graver parked on derivatives			
Other (describe): <u>~~</u>			
Outer (deserve). 7			
A fast B	f telesconed or more than one screen, describe on next page		
Top of lap pipe or reduction in casing: <u></u> feet. <u>D</u>	f <u>telescoped or more than one screen, describe on next page</u> Form: OLWR-SWR-1A		

MAY 0 4 2006 BY: OLWR


), 97

## The sketch below only required for water wells

## Description of formations encountered must be provided for all wells and borcholes, unless specifically exempted by regulations

<u>f well telescopes, show depths on sketch</u> Ground Level	Description of Formations Encountered		To (depth)
	clay dist.	Ground Level	30
	red Soud	20	<u> Ə</u> 5-
	gravel	25-	30
	while clay	30	60
	while scuol	60	20
	white clay	70	71
	while sovel	21	130
			<u> </u>
	,		
		<b></b>	4
			<u> </u>
		4	
•		<u></u>	
			1

If more than one screen, show location of each on sketch

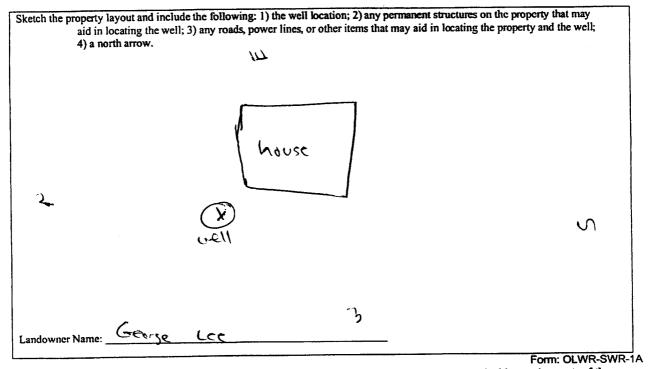

I certify that the well/borehole was drilled, constructed, and completed in accordance with all applicable requirements of the Mississippi Department of Environmental Quality and the Mississippi Department of Health regulations, if applicable, and state

5-1-06

Date

laws. J- Meson )one

Print Name of Responsible Licensee and License No.

0630

' Signature of Licensee

MAY 0 4 2006 BY: OLWR

RECEIVED

STATE WELL REPORT						
Permit #: Mississippi Depart Driller: Mississippi Depart Office of La Date completed: 4-3-06 Jackso ( Copy information from block on Part 1 (60)	Part 2 For Office Use Only:   Her's Completion Report Aquifer:   and and Water Resources Aquifer:   .0. Box 10631 Well #: D - 97   bon, MS 39289-0631 Elevation:   1)354-6938 (fax) Elevation:					
This part of the report must be completed by a licensed water well contractor or a licensed pump installer. A copy of Part 1 of the report must be attached and both parts filed with the Department at the above address within 30 days of well completion.						
Well Owner Information	Well Location					
Owner Name: <u>George Lee</u> . Mailing Address: <u>LOT 14</u> <u>Soudy Fidge</u> <u>Buholia</u> <u>Ms</u> <u>38611</u> City State Zip Code	Latitude: $34.54.531$ Longitude: $85.43.030$ <b>32</b> Method of Lat/Long (check one): Conventional Survey, USGS quad, Hand-held GPS, Survey-grade GPS, NE $\frac{1}{2}$ Swo $\frac{1}{2}$ Sec, T, R,					
Telephone No. (101) 387- 70 (8	Distance Direction Nearest Town 313 Miles 50 of Barton-					
Pump Type	Power Type					
Circle one	Circle one					
Air Lift Jet Submersible	Diesel Engine Gasoline Engine Natural Gas					
Bucket Piston Turbine	Electric Motor Hand Tractor PTO					
Centrifugal Rotary Flowing Well	Windmill Other (specify):					
Other (specify):	Horse Power Rating of Motor:314					
Date Pump Installed: 4-3-06	Setting Depth:feet					
Rated Pump Capacity: Gallons Per Minute						
Pump Test Data	Method of Measuring Water Level					
Date Well Tested: <u>4-3-06</u> Static Water Level (A): <u>70</u> Feet Below Land Surface Pumping Water Level (B): <u>FA</u> Feet Below Land Surface	Other (specify): <u>String</u> ( weight					
Drawdown [(B) - (A)]:Feet Below Land Surfac	e For flowing well, measured shut in head:fcet					
Test Pumping Rate: 12 Gallons Per Minute	12					
Duration of Pump Test (minimum 4 hours): <u>34</u> hours	hours of pumping					
I HEREBY CERTIFY that the above statements are true to the best of my knowledge.    Jones Jo						

٠

i e

MAY 0 4 2006 BY: OLWR