County: Morshall	State Well Report Part 1 – Driller's Log	For Office Use Only:
Permit #: Driller: Jones W-Meson Date drilling completed: 9-7-07	Mississippi Department of Environmental Quality Office of Land and Water Resources P.O. Box 10631 Jackson, MS 39289-0631 (601)961-5210	Aquifer:
	(601)354-6938 (fax) (fax	

Information on Well Owner	Well or Borehole Location	
(Landowner if borehole is not for a water well)	34.53 805	
Owner Name Johnsy Hill	Latitude: <u>39°53</u> , <u>805</u> " Longitude: <u>89°40</u> , <u>979</u> " 48 Method of Lat/Long (circle one): Conventional Survey,	
Mailing Address: 219 grovel pit	USGS quad, Hand-held GPS, Survey-grade GPS	
Byholic Ms <u>38611</u> City State Zip Code Telephone No. <u>901</u> <u>428 - 3954</u>	SE 14 10 14 Sec 24 Twn 25 Rng 55 NE SW Distance Direction Nearest Town Miles N of Bybolig	
Well / Bore	hole Data	
Date drilling started: $\underline{9 - 7 - 97}$ Date drilling completed: $\underline{9 - 7 - 97}$		
Location of the source of any surface water used for drilling:	lopment: <u>MA</u>	
Logs run (circle all applicable): No log run Electric Gamma Ray Density Sonic Neutron Other:		
Purpose of borehole (check one): Water Well Geotechnical/Geological Investigation Ground Source Heat Pump		
Seismic SurveyOther (<i>describe</i>) If drilling is not related to water well construction, skip the remainder of this block		
Purpose of Well (check one): Home 🖌 Industrial Public Supply Irrigation Fish Culture Other:		
If a flowing well, method of flow regulation: Valve <u>NA</u> C	Other (describe)	
Static Water Level: feet above or below (circle one) land surface Date measured: $9 - 7 - 07$		
Method of Measurement (circle one) steel tape electric tape air line other: <u>String (weight</u>		
Well depth: <u>155</u> Well grouted to a depth of <u>16</u> feet Type of grout (circle one): Neat Cement Bentonite Mix		
Casing length: <u>145</u> feet Casing diameter: <u>4</u> inches Type of casing: <u>pvc</u>		
Screen length: 10 feet Screen diameter: inches Type of screen:		
Screen slot size: 010 inches Setting depth: From 145 feet to 155 feet		
Type of completion (circle all applicable): Gravel packed Underreamed Telescoped Open hole Natural Development		
Other (describe):		
Top of lap pipe or reduction in casing:	elescoped or more than one screen, describe on next page	


Form: OLWR-SWR-1A

and the second s

n na seat

The sketch below only required for water wells


If well telescopes, show depths on sketch. Ground Level_____

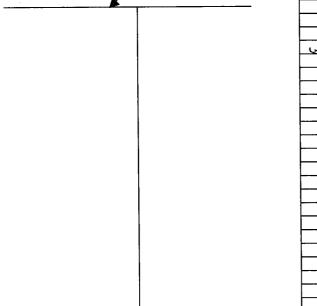

Description of formations encountered must be provided for all
wells and boreholes, unless specifically exempted by regulations

Description of Formations Encountered	From (depth)	To (depth)
cley dirt.	Ground Level	10
larorel	(0)	38
white clay	96	35
while soud	35	80
while clay	80	100
While soud	100	155
		ļ
		-
	-	1 1
	1	
		1

If more than one screen, show location of each on sketch

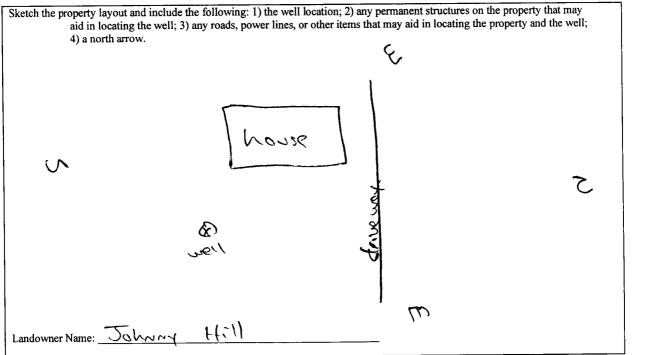

Form: OLWR-SWR-1A

I certify that the well/borehole was drilled, constructed, and completed in accordance with all applicable requirements of the Mississippi Department of Environmental Quality and the Mississippi Department of Health regulations, if applicable, and state

Jores w. N		-3-07. Janow.Ma	
Print Name of Responsibl	e Licensee and License No. I	Date Signature of Licensee	
		607 n a 2587	0.10 ¹¹ 9 2007
orie s V. C.I.V. H	And the second	And the second	

STATE WELL REPORT			
County: Marshall	Р	art 2	
	-	s Completion Report	For Office Use Only:
Permit #:	Mississippi Department of Environmental Quality		Aquifer:
Driller: Jones w. Mosn.		and Water Resources Box 10631	<u> </u>
Date completed: <u>(-)-0)</u>	Jackson, N	4S 39289-0631 961-5210	well #: <u>D-120</u>
Copy information from block on Part 1	· · ·	4-6938 (fax)	Elevation:
report must be attached and both parts filea	This part of the report must be completed by a licensed water well contractor or a licensed pump installer. A copy of Part 1 of the report must be attached and both parts filed with the Department at the above address within 30 days of well completion.		
Well Owner Information)n	Well	Location
Owner Name: Johnny Hill		Latitude: 34.53.805	Longitude: 89.40.579
Mailing Address: 219 grovel	pit	Method of Lat/Long (check on	<i>.</i>
			GPS_ <i>L</i> , Survey-grade GPS
<u>Byholia M5</u> City State	<u>3861</u> Zip Code	SE 1/ NW 1/ Sec 71	TJS R JU
		Distance Direction	Nearest Town
Telephone No. (901) 428-39	54	Miles of	Byholia
Pump Type Circle one			ver Type rcle one
	Submersible		e Engine Natural Gas
	Turbine	Electric Motor Hand	Tractor PTO
Centrifugal Rotary	Flowing Well	Windmill Other (specify):
Other (specify):		Horse Power Rating of Motor:	314
Date Pump Installed: <u>9-7-07</u>		Setting Depth:	<u>©</u> feet
Rated Pump Capacity: 10	Gallons Per Minute	Number of Stages:	
Pump Test Data		Mathod of Ma	asuring Water Level
•			ircle one
Date Well Tested: $9 - 9 - 87$		Air Line Electric Mea	suring Line Steel Tape
	Below Land Surface	Other (specify): 5tring	Ineight
Pumping Water Level (B): <u>NA</u> Feet B	elow Land Surface		
	Below Land Surface	For flowing well, measured sh	
	Gallons Per Minute	Well yielded (O	_GPM with a drawdown of
Duration of Pump Test (minimum 4 hours): _	hours	feet after	<u><u><u></u>hours of pumping</u></u>
I HEREBY CERTIFY that the above statements are true to the best of my knowledge.			

. .

¥

I HEREBY CERTIFY that the above statements are true to the best of my knowledge.		
Jones W. Meson 0-620	Jens v. Marca,	
Print Name of Pump Installer and License No. (if applicable)	Usignature of Pump Installer	
	Form: OLWR-SWR-1B	

Form: OLWR-SWR-1B