

Marshall  
D 2000  
7-5-75

MISSISSIPPI  
 BOARD OF WATER COMMISSIONERS  
 416 North State Street  
 Jackson, Mississippi 39201

WATER WELL DRILLERS LOG

7-5-1975 <sup>15E</sup> W.A. Messer Marshall  
Water Well Contractors  
 date well completed firm name county well located


LANDOWNER:	description of formations encountered	from	to
<u>Jago Marciano</u> <u>RT-1- Bighalia Meadows</u> (mailing address)			
WELL LOCATION:	<u>Red sand</u>	<u>15</u>	<u>20</u>
sec. <u>11</u> T. <u>2</u> N. R. <u>5</u> E. <u>2 3/4</u> miles <u>North</u> of <u>Bighalia</u> (distance) (direction) (nearest town)	<u>gravel</u>	<u>20</u>	<u>30</u>
WELL PURPOSE: <u>Home</u> (home, irrigation, municipal, industrial)	<u>white clay</u>	<u>30</u>	<u>40</u>
WELL COMPLETION DATA:	<u>white sand</u>	<u>40</u>	<u>94</u>
(1) diameter (inches) <u>4"</u>			
(2) total depth (feet) <u>94'</u>			
(3) static water level (feet) <u>50</u> below top of ground.			
(4) casing <u>Plaster</u> , <u>84'</u> (material) (depth) <u>4"</u> (size) if telescope see back.			
(5) screen <u>10' - 84'</u> (length) (depth to top) <u>4"</u> , <u>Plaster</u> (size) (material)			
(6) pump <u>3/4</u> <u>10</u> (HP) (yield gpm) <u>electric</u> (type power)			
(7) electric log <u>No</u> (yes or no)  (organization running log)			
(8) how well bottom plugged <u>Caps on screen</u>			
DRILLERS REMARKS:			

INDEXED  
 FILED  
 FEB 17 1976

MISS. BD. OF WATER COMMISSIONERS

If well telescopes please sketch and show depths.

GROUND LEVEL

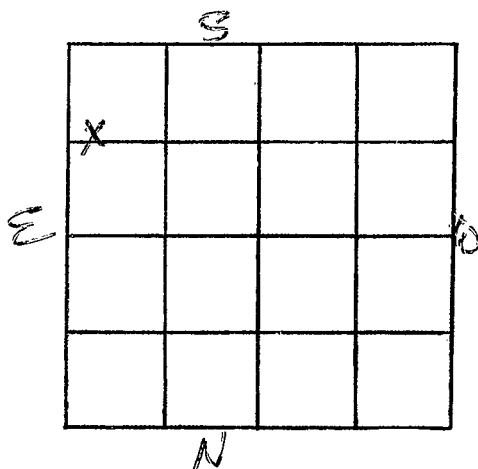

SECTION 11

Please indicate well location X.

ADDITIONAL INFORMATION

If more than one screen, show locations of each on sketch.