

MARSHALL
D 2004
1-29-76

MISSISSIPPI
BOARD OF WATER COMMISSIONERS
416 North State Street
156 Jackson, Mississippi 39201

WATER WELL DRILLERS LOG

1-29-76 date well completed 1976 W. A. Mason firm name Marshall county well located


LANDOWNER:	description of formations encountered	from	to
A. E. Wornack	clay silt	0	10
R. F. D. Byhalia Miss. (mailing address)	yellow clay	10	17
WELL LOCATION:	gravel	17	24
sec. 11 T. 2 N. R. 5 E. S. 3 W.	red sand	24	55
3 1/4 miles North Byhalia (distance) (direction) (nearest town)	white sand	55	130
WELL PURPOSE: Home (home, irrigation, municipal, industrial)			
WELL COMPLETION DATA:			
(1) diameter (inches) 4"			
(2) total depth (feet) 130'			
(3) static water level (feet) 88' below top of ground.			
(4) casing PVC Plastic 120' (material) (depth)			
4 1/2" If telescope see back. (size)			
(5) screen 10' 120' (length) (depth to top)			
4" PVC Plastic (size) (material)			
(6) pump 1 1/2 HP 10 (HP) (yield gpm)			
electric (type power)			
(7) electric log No (yes or no)			
(organization running log)			
(8) how well bottom plugged Cap on screen			
DRILLERS REMARKS:			

RECEIVED
JUN 28 1976

MISS. BD. OF WATER COMM

If well telescopes please
sketch and show depths.

GROUND LEVEL

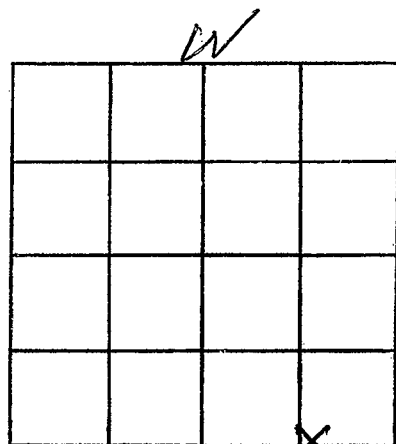

SECTION 11

Please indicate well location X.

ADDITIONAL INFORMATION

If more than one screen,
show locations of each on sketch.