

MARSHALL
D 2006
7-15-76

MISSISSIPPI
BOARD OF WATER COMMISSIONERS
416 North State Street
Jackson, Mississippi 39201

WATER WELL DRILLERS LOG

7-15-
date well completed

15E W.G. Mason
76 Water Level Control
firm name

Marshall
county well located

LANDOWNER:	description of formations encountered	from	to
<u>Dr. L. Hood Jr.</u>			
<u>P.O. Byhalia Miss.</u> (mailing address)	<u>Red sand</u>	<u>6</u>	<u>40</u>

WELL LOCATION:

sec. 36 T. 2 N. R. 5
1/2 miles east of Byhalia
(distance) (direction) (nearest town)

WELL PURPOSE: Drainage
(home, irrigation, municipal, industrial)

WELL COMPLETION DATA:

- diameter (inches) 4"
- total depth (feet) 95'
- static water level (feet) 34' below top of ground / 34' above
- casing Plastic 85'
(material) (depth)
4"
(size) If telescope see back.
- screen 10' 85'
(length) (depth to top)
4" Plastic
(size) (material)
- pump 1/3 10
(HP) (yield gpm)
Electric
(type power)
- electric log NO
(yes or no)

(organization running log)

(8) how well bottom plugged Cap

DRILLERS REMARKS:


RECEIVED

III 7 - 1977

MISS. BOB. OF WATER COMMISSIONERS

If well telescopes please sketch and show depths.

GROUND LEVEL

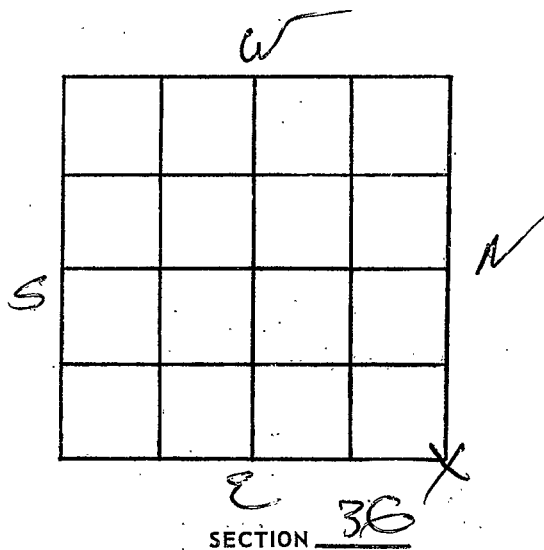

Please indicate well location X.

ADDITIONAL INFORMATION

If more than one screen, show locations of each on sketch.