

MARSHALL
D 2007

MISSISSIPPI
BOARD OF WATER COMMISSIONERS
416 North State Street
Jackson, Mississippi 39201

WATER WELL DRILLERS LOG

7/3/76 date well completed
Medlin Well Drilling firm name
Marshall county well located

need section - if...

LANDOWNER: EARL James

description of formations encountered

from to

Walnut M.S.
(mailing address)

Clay
sand

0 30
30 130

WELL LOCATION:

sec. 212 N SE
S W
2 miles west of P. Ark
(distance) (direction) (nearest town)

WELL PURPOSE: Home
(home, irrigation, municipal, industrial)

WELL COMPLETION DATA:

- (1) diameter (inches) 4"
- (2) total depth (feet) 130'
- (3) static water level (feet) 60' below top of ground.
- (4) casing P/S 130'
(material) (depth)
(size) if telescope see back.
- (5) screen 10' 120'
(length) (depth to top)
030' P/S
(size) (material)
- (6) pump 1/2 10
(HP) (yield gpm)
(type power)
- (7) electric log (yes or no)
(organization running log)
- (8) how well bottom plugged


RECEIVED

DEC 2 1976

DRILLERS REMARKS:

If well telescopes please sketch and show depths.

GROUND LEVEL

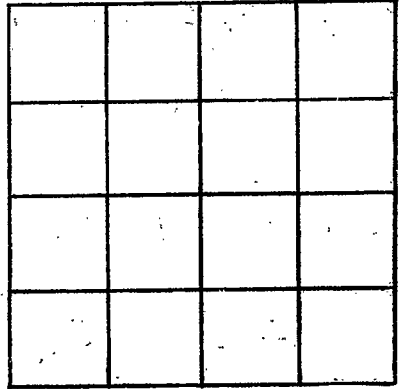

SECTION _____

Please indicate well location X.

ADDITIONAL INFORMATION

If more than one screen, show locations of each on sketch.