

MARSHALL

D 2008

6-10-76

MISSISSIPPI BOARD OF WATER COMMISSIONERS  
416 North State Street  
Jackson, Mississippi 39201

WATER WELL DRILLERS LOG

June 10 1976 R. L. Carpenter Marshall  
date well completed firm name county well located

LANDOWNER: Bobby Rice  
Brylavia, Miss.  
RFD  
(mailing address)

WELL LOCATION:  
sec. 30 T. 2 N. R. 5 E  
3 miles Northwest of Brylavia  
(distance) (direction) (nearest town)

WELL PURPOSE: None  
(home, irrigation, municipal, industrial)

WELL COMPLETION DATA:  
(1) diameter (inches) 4  
(2) total depth (feet) 165  
(3) static water level (feet) 40 below top of ground  
(4) casing Plastic, 159' (material) (depth)  
(size) if telescope see back.  
(5) screen 6' 159' (length) (depth to top)  
4" Plastic & Thread (size) (material)  
(6) pump 3/4 12 (HP) (yield gpm)  
5hp (type power)  
(7) electric log No (yes or no)  
(organization running log)  
(8) how well bottom plugged Plastic cap

description of formations encountered	from	to
Surface Soil	0	15
Red Red Sand	15	32
Red white sand	32	90
White Fine Sand & Clay, mixed	90	130
White coarse sand	130	165


RECEIVED  
MAY 12 1978

MISS. BD. OF WATER COMMISSIONERS

DRILLERS REMARKS:

If well telescopes please sketch and show depths.

GROUND LEVEL:

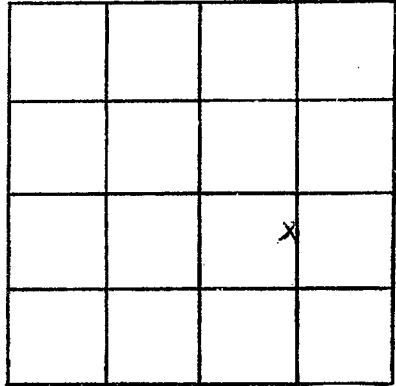

SECTION 30

Please indicate well location X.

ADDITIONAL INFORMATION

If more than one screen,  
show locations of each on sketch.