

Marshall  
D 2010  
Jan. 1977

MISSISSIPPI  
BOARD OF WATER COMMISSIONERS  
416 North State Street  
Jackson, Mississippi 39201

WATER WELL DRILLERS LOG

date well completed Jan 1977 19 1977 firm name Leake Well Co county well located Marshall

LANDOWNER: Frank Davis

description of formations encountered

from to

Colliersville BtH

Surface Clay 0 19  
Clay gravel & Sand 19 57  
Clay 57 67  
Sand & Clay 67 105  
@ coarse sand 105 145

Tenn

(mailing address)

WELL LOCATION:

sec. 1 T 2 R S E  
5 miles S of Colliersville  
(distance) (direction) (nearest town)

WELL PURPOSE: Home  
(home, irrigation, municipal, industrial)

WELL COMPLETION DATA:

- (1) diameter (inches) 4
- (2) total depth (feet) 145
- (3) static water level (feet) 87 below above top of ground.
- (4) casing PVC 135  
(material) (depth)  
(size) if telescope see back.
- (5) screen 10' 135  
(length) (depth to top)  
4" PVC  
(size) (material)
- (6) pump 1 22  
(HP) (yield gpm)  
Elec  
(type power)
- (7) electric log NO  
(yes or no)

(organization running log)

(8) how well bottom plugged PVC - 2/2


DRILLERS REMARKS:

RECEIVED  
JUN 19 9 1977

MISS. Bd. OF WATER COMMISSIONERS

If well telescopes please  
sketch and show depths.

GROUND LEVEL

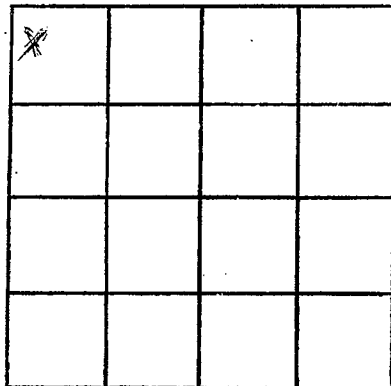

SECTION   /  

Please indicate well location X.

ADDITIONAL INFORMATION

If more than one screen,  
show locations of each on sketch.