

MARSHALL
D 2011
6-22-77

MISSISSIPPI
 BOARD OF WATER COMMISSIONERS
 416 North State Street
 15E Jackson, Mississippi 39201

WATER WELL DRILLERS LOG

June 22 1977 Earl Jones Well Co. Marshall
 date well completed firm name county well located

LANDOWNER:
Dean Jackson
Byhalia Miss. RT 1
 (mailing address)

WELL LOCATION:
 sec. 24 T. 2 N. R. 5 E.
2 1/2 miles NE of Byhalia
 (distance) (direction) (nearest town)

WELL PURPOSE: Home
 (home, irrigation, municipal, industrial)

- WELL COMPLETION DATA:
- (1) diameter (inches) 4"
 - (2) total depth (feet) 145
 - (3) static water level (feet) 110 below above top of ground.
 - (4) casing plastic 135'
 (material) (depth)
 - 4" if telescope see back.
 (size)
 - (5) screen 10' 135'
 (length) (depth to top)
 - 4" - 013 plastic
 (size) (material)
 - (6) pump 1/2 16
 (HP) (yield.gpm)
 - Electric
 (type power)
 - (7) electric log no
 (yes or no)
 - (organization running log)
 - (8) how well bottom plugged.
plastic cap

description of formations encountered	from to	
<u>Topsoil & clay</u>	<u>0</u>	<u>16</u>
<u>sand</u>	<u>16</u>	<u>20</u>
<u>clay</u>	<u>20</u>	<u>22</u>
<u>sand</u>	<u>42</u>	<u>60</u>
<u>sand & gravel</u>	<u>60</u>	<u>65</u>
<u>sand</u>	<u>65</u>	<u>80</u>
<u>clay</u>	<u>80</u>	<u>88</u>
<u>sand</u>	<u>88</u>	<u>120</u>
<u>clay</u>	<u>120</u>	<u>125</u>
<u>sand</u>	<u>125</u>	<u>145</u>


RECEIVED
 JUL 5 - 1977

MISS. RD. UE WATER COMMISSIONERS

DRILLERS REMARKS:

If well telescopes please sketch and show depths.

GROUND LEVEL

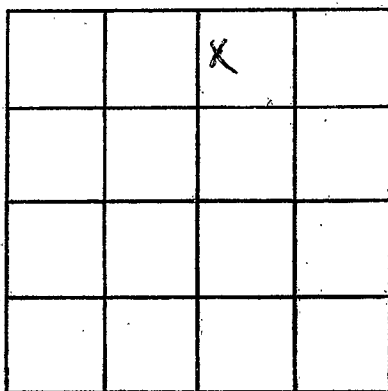

SECTION 24

Please indicate well location X.

ADDITIONAL INFORMATION

If more than one screen, show locations of each on sketch.