

Marshall
 D 2012
 8/22/77

MISSISSIPPI
 BOARD OF WATER COMMISSIONERS
 416 North State Street
 Jackson, Mississippi 39201

WATER WELL DRILLERS LOG

8-22-1977 ^{W.A. Mason} Water Well Contr Marshall
 date well completed firm name county well located

LANDOWNER:
 Kent, Wilbanks & Market
 RFD - Bayhalia Miss
 (mailing address)

description of formations encountered	from	to
Hard Clay	0	12
Red Sand	12	60
Yellow Sand	60	100
White Clay	100	122
White Clay	122	152

WELL LOCATION:
 sec. 14 T. 2 N. R. 15 E.
 2 1/4 miles N.W. of Bayhalia
 (distance) (direction) (nearest town)

WELL PURPOSE: Home
 (home, irrigation, municipal, industrial)

- WELL COMPLETION DATA:
- (1) diameter (inches) 4"
 - (2) total depth (feet) 152'
 - (3) static water level (feet) 56' below top of ground
 - (4) casing Plastic, 132'
 (material) (depth)
4" If telescope see back.
 (size)
 - (5) screen 20', 132'
 (length) (depth to top)
4", Plastic
 (size) (material)
 - (6) pump 3/4 10
 (HP) (yield gpm)
electric
 (type power)
 - (7) electric log NO
 (yes or no)


(organization running log)
 (8) how well bottom plugged caps

DRILLERS REMARKS:

RECEIVED
 DEC 12 1977

If well telescopes please sketch and show depths.

GROUND LEVEL

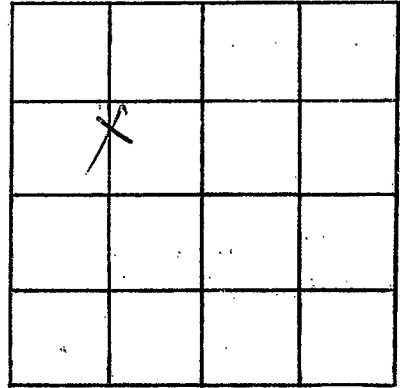

SECTION 14

Please indicate well location X.

ADDITIONAL INFORMATION

If more than one screen, show locations of each on sketch.