

MARSHALL

D 2074

6/11/78

MISSISSIPPI BOARD OF WATER COMMISSIONERS
416 North State Street
Jackson, Mississippi 39201

WATER WELL DRILLERS LOG

6/11/78
date well completed

1978 Lease Well Co
firm name

Marshall
county well located

LANDOWNER:
AB Helms

Byhalia Miss
(mailing address)

WELL LOCATION:
sec 2 T 25 N R 5 W E
S S E W
2 miles N of Byhalia
(distance) (direction) (nearest town)

description of formations encountered	from	to
Surface Clay	0	12
Gravel + Sand	12	50
Sand + clay	50	100
Coarse Sand	100	140

WELL PURPOSE:
(home, irrigation, municipal, industrial)

- WELL COMPLETION DATA:
- (1) diameter (inches) 4
 - (2) total depth (feet) 140
 - (3) static water level (feet) 110 below top of ground.
 - (4) casing PVC 130
(material) (depth)
4 if telescope see back.
(size)
 - (5) screen 10 130
(length) (depth to top)
4 PVC
(size) (material)
 - (6) pump 1/2 15
(HP) (yield gpm)
elec
(type power)
 - (7) electric log no
(yes or no)

(organization running log)

(8) how well bottom plugged PVC cap.


DRILLERS REMARKS:

RECEIVED
JUN 20 1978

MISS. BD. OF WATER COMM.

If well telescopes please sketch and show depths.

GROUND LEVEL

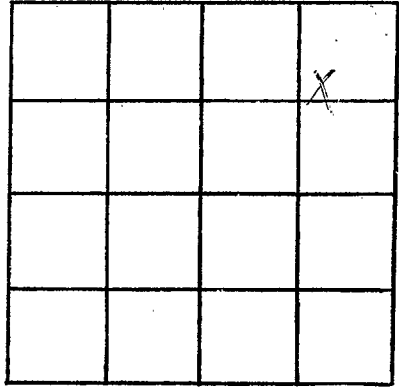

SECTION 14

Please indicate well location X.

ADDITIONAL INFORMATION

Lined area for additional information.

If more than one screen, show locations of each on sketch.