

Marshall
D 2017
1-24-80

MISSISSIPPI
BOARD OF WATER COMMISSIONERS
416 North State Street
Jackson, Mississippi 39201

CODED

WATER WELL DRILLERS LOG

1-24 1980 Gravel Well Co Marshall
date well completed firm name county well located

LANDOWNER:
John Williams
Rt. 1, Bayalia
(mailing address)

description of formations encountered	from	to
<u>Red sand</u>	<u>0</u>	<u>40</u>
<u>White sand with clay</u>	<u>40</u>	<u>80</u>
<u>White sand</u>	<u>80</u>	<u>125</u>

WELL LOCATION:
sec. 23 T. 2 N. R. 5 E
2 1/2 miles N of Bayalia
(distance) (direction) (nearest town)

WELL PURPOSE: home
(home, irrigation, municipal, industrial)

- WELL COMPLETION DATA:
- (1) diameter (inches) 4 in
 - (2) total depth (feet) 125
 - (3) static water level (feet) 80 below top of ground.
 - (4) casing PVC, 125
(material) (depth)
 - (size) if telescope see back.
 - (5) screen 7 ft, 118
(length) (depth to top)
 - 4 in, Gravel
(size) (material)
 - (6) pump 1/2, 210
(HP) (yield gpm)
 - 220
(type power)
 - (7) electric log No
(yes or no)
 - (organization running log)
 - (8) how well bottom plugged cap

DRILLERS REMARKS:


DEPT. OF NATURAL RESOURCES
BUREAU OF LAND & WATER RESOURCES

FEB 15 1980

RECEIVED

If well telescopes please
sketch and show depths.

GROUND LEVEL

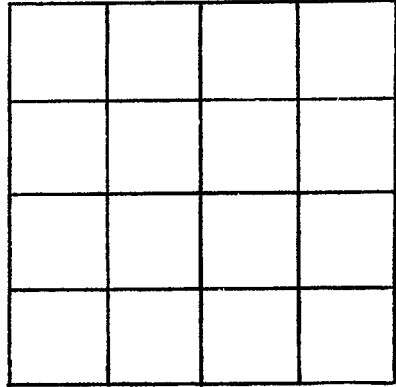

SECTION _____

Please indicate well location X.

ADDITIONAL INFORMATION

If more than one screen,
show locations of each on sketch.