

MARSHALL
D 2018
7-9-80

MISSISSIPPI
 BOARD OF WATER COMMISSIONERS
 416 North State Street
 Jackson, Mississippi 39201

WATER WELL DRILLERS LOG

7/9/80 19 Top Well Marshall
 date well completed firm name county well located

LANDOWNER:
Ralph Palmer
Bubala, Ms
 (mailing address)

description of formations encountered	from	to
<u>Top Soil</u>	<u>0</u>	<u>3</u>
<u>red clay</u>	<u>5</u>	<u>60</u>
<u>red sand</u>	<u>60</u>	<u>80</u>
<u>white sand</u>	<u>80</u>	<u>190</u>

WELL LOCATION:

sec 10 T 2 N 3 R 5 E
3 miles N of Bubala
 (distance) (direction) (nearest town)

WELL PURPOSE:

(home, irrigation, municipal, industrial)

WELL COMPLETION DATA:

- (1) diameter (inches) 4"
- (2) total depth (feet) 190'
- (3) static water level (feet) 30' below top of ground.
- (4) casing plastic, 190'
 (material) (depth)
 (size) If telescope see back.
- (5) screen 10' 190'
 (length) (depth to top)
4" plastic
 (size) (material)
- (6) pump 1/2 10
 (HP) (yield gpm)
elec.
 (type power)
- (7) electric log (yes or no)
 (organization running log)
- (8) how well bottom plugged cap

DEPT. OF NATURAL RESOURCES
 BUREAU OF LAND & WATER RESOURCES


OCT 15 1980

RECEIVED

DRILLERS REMARKS:

If well telescopes please sketch and show depths.

GROUND LEVEL

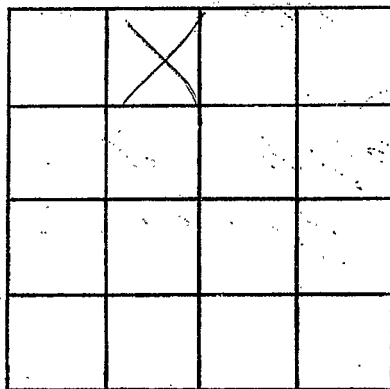

SECTION _____

Please indicate well location X.

ADDITIONAL INFORMATION

If more than one screen,
show locations of each on sketch.