

MISSISSIPPI DEPARTMENT OF NATURAL RESOURCES

Bureau of Land and Water Resources

Southport Mall

P.O. Box 10631

Jackson, Mississippi 39209

WATER WELL DRILLERS LOG

Marshall  
D 2001

9-22 1983 Hicks Well CO Marshall  
date well completed firm name county well located

LANDOWNER: John Williams  
P.O. Box 312 CB90  
Byhalis, Miss, 38611  
(mailing address)

description of formations encountered	from	to
<u>Red clay</u>	<u>0</u>	<u>10</u>
<u>Red sand</u>	<u>10</u>	<u>30</u>
<u>Red Sand + clay</u>	<u>30</u>	<u>60</u>
<u>White sand + clay</u>	<u>60</u>	<u>110</u>
<u>White Sand</u>	<u>110</u>	<u>140</u>

WELL LOCATION:  
sec. 14 T. 2 N. R. 5 E  
3 miles N of Byhalis  
(distance) (direction) (nearest town)

WELL PURPOSE: Home  
(home, irrigation, municipal, industrial)

- WELL COMPLETION DATA:
- (1) diameter (inches) 4
  - (2) total depth (feet) 140
  - (3) static water level (feet) 80 below above top of ground.
  - (4) casing PVC, 140'  
(material) (depth)  
4" If telescope see back.  
(size)
  - (5) screen 10', 130'  
(length) (depth to top)  
1013, PVC  
(size) (material)
  - (6) pump 1/2 10  
(HP) (yield gpm)  
220V  
(type power)
  - (7) electric log No  
(yes or no)  
(organization running log)
  - (8) how well bottom plugged CRP

DEPT. OF NATURAL RESOURCES  
BUREAU OF LAND & WATER RESOURCES


OCT 13 1983

RECEIVED

DRILLERS REMARKS:

If well telescopes please sketch and show depths.

GROUND LEVEL

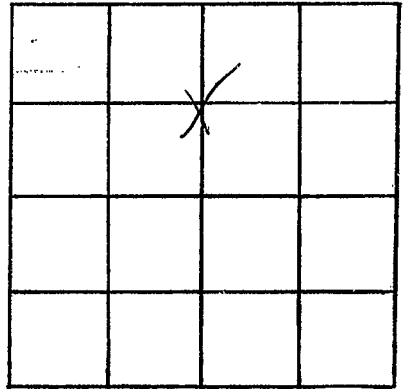

SECTION 14

Please indicate well location X.

ADDITIONAL INFORMATION

If more than one screen,  
show locations of each on sketch.