

MISSISSIPPI DEPARTMENT OF NATURAL RESOURCES

Bureau of Land and Water Resources

Southport Mall

P.O. Box 10631

Jackson, Mississippi 39209

WATER WELL DRILLERS LOG

Marshall
D
2023

July 21 1982 B. L. Carpenter Marshall
date well completed firm name county well located

LANDOWNER: Clay Allen
Byrdellia, Miss
RFD
(mailing address)

description of formations encountered	from	to
surface soil	0	15
Red clay & gravel	15	35
white clay	35	60
med. white sand	60	92
Coarse white sand	92	130

WELL LOCATION:
sec. 11 T. 2 N R. 5 E
S W
3 miles north of Byrdellia
(distance) (direction) (nearest town)

WELL PURPOSE: Home
(home, irrigation, municipal, industrial)

- WELL COMPLETION DATA:
- (1) diameter (inches) 4
 - (2) total depth (feet) 130
 - (3) static water level (feet) 20 below above top of ground.
 - (4) casing Plastic, 120,
(material) (depth)
(size) If telescope see back.
 - (5) screen 10', 120'
(length) (depth to top)
1/4" PVC
(size) (material)
 - (6) pump 3/4 12
(HP) (yield gpm)
Elec
(type power)
 - (7) electric log no
(yes or no)
(organization running log)
 - (8) how well bottom plugged PVC cap


DRILLERS REMARKS:

DEPT. OF NATURAL RESOURCES
BUREAU OF LAND & WATER RESOURCES

OCT 20 1982
RECEIVED

If well telescopes please sketch and show depths.

GROUND LEVEL

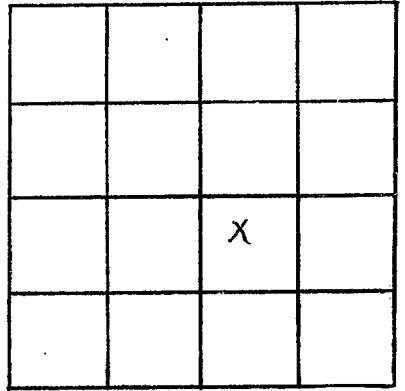

SECTION 11

Please indicate well location X.

ADDITIONAL INFORMATION

If more than one screen,
show locations of each on sketch.