

MISSISSIPPI DEPARTMENT OF ENVIRONMENTAL QUALITY
Bureau of Land and Water Resources

P. O. Box 10631
Jackson, MS 39289-0631
WATER WELL DRILLERS LOG

COUNTY WELL LOCATED
MARSHALL

WELL NUMBER **A 2035** CODED

DATE WELL COMPLETED
4-25-91

PERMIT NUMBER

NAME OF DRILLING FIRM
HICKS WELL CO.

RT. 1 BOX 157
SENATOBIA, MS 38668

NAME & MAILING ADDRESS OF LANDOWNER
Richard H. Davis

14441 Pidgou Rd

Byhalia, ms 38611

WELL LOCATION: SEC **34** TOWNSHIP **2** RANGE **5** **(S) (E)**

DISTANCE **3** Miles DIRECTION **SW** of NEAREST TOWN **Byhalia**

OTHER LANDMARK

WELL PURPOSE: Home Irrigation, Municipal, Industrial, Fish Pond, etc.

PUMP DATA

PUMP TYPE (Circle One):
 Submersible Turbine, Jet Flowing Well,
Other (Describe)

POWER TYPE (Circle One):
 Electric Tractor, Diesel, Gasoline, Butane,
Other (Describe) **H/P 1/2**

Pump Capacity (GPM)	No. of Stages	Setting Depth
10	9	120 FT.

PUMP TEST

Well yielded **10** GPM with
a drawdown of _____ ft.
after _____ hours of pumping

WELL DATA

Well Depth 155	Casing Diameter (In.) 4	Casing Length (Ft.) 145
Type of Casing PVC	Hole Depth 155	Depth to Static Water Level 95

TYPE OF COMPLETION: (Circle One or More):
 Gravel Packed, Underreamed, Telescoped,
 Natural Development, Open Hole, Other

Top of Lap Pipe or Reduction in Casing

FEET IF TELESCOPED OR MORE THAN ONE SCREEN: USE BACK PAGE

LOG DATA

TYPE OF LOG RUN (Circle One): No Log Run,
 Electric, Gamma Ray, Density, Sonic, Neutron,
Other (Describe)

Name of Organization Running Log

SCREEN DATA

Diameter - Inches 4	Length - Feet 10	Slot Size - Inches 0.13
Screen Type PVC	Depth to Bottom - Feet 10	

GEOLOGIC DATA (Office Use Only)

Surface Elev.	Geologic Unit	Unit Thickness	Depth to Top
Subs. SWL	Date	Analysis	Aquifer Test

Driller's Remarks


DESCRIPTION OF FORMATIONS ENCOUNTERED	FROM	TO
Dirt	0	10
SAND & gravel	10	80
clay	80	125
SAND	125	155

FORMATIONS (Continued)	FROM	TO
RECEIVED		
MAY 14 1991		
Dept. of Environmental Quality Bureau of Land & Water Resources		

IF MORE SPACE IS NEEDED, USE BACK

If well telescopes please
sketch and show depths.

GROUND LEVEL

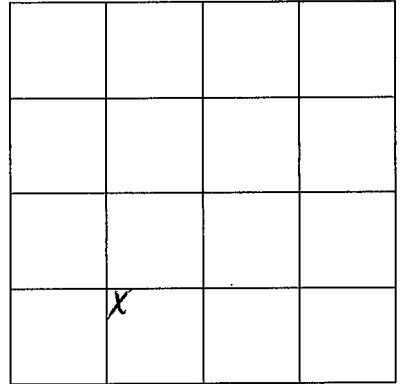

SECTION _____

Please indicate well location X.

ADDITIONAL INFORMATION

If more than one screen,
show location of each on sketch.