

Marshall
 D 2037
 1/26/77

MISSISSIPPI
 BOARD OF WATER COMMISSIONERS
 416 North State Street
 Jackson, Mississippi 39201

WATER WELL DRILLERS LOG

1/26 1977 Dick Well Co. Marshall
 date well completed firm name county well located

LANDOWNER: N.B. Williams
Rt. 3
Byhalis, Miss.
 (mailing address)

description of formations encountered	from	to
<u>Red clay & sand</u>	<u>0</u>	<u>10</u>
<u>white clay</u>	<u>10</u>	<u>80</u>
<u>Red clay</u>	<u>80</u>	<u>110</u>
<u>White sand</u>	<u>110</u>	<u>150</u>

WELL LOCATION:
 sec. 24 T. 2 N. R. 5 E
1/2 miles N of Byhalis
 (distance) (direction) (nearest town)

WELL PURPOSE: Home
 (home, irrigation, municipal, industrial)


- WELL COMPLETION DATA:
- (1) diameter (inches) 4
 - (2) total depth (feet) 150
 - (3) static water level (feet) 80 below above top of ground.
 - (4) casing PVC, 150,
 (material) (depth)
 (size) if telescope see back.
 - (5) screen 7ft, 143
 (length) (depth to top)
4", gravel type
 (size) (material)
 - (6) pump 1/2 10
 (HP) (yield gpm)
220V
 (type power)
 - (7) electric log No
 (yes or no)
 - (organization running log)
 - (8) how well bottom plugged Cap

DRILLERS REMARKS:

RECEIVED
 NOV 30 1977

If well telescopes please sketch and show depths.

GROUND LEVEL

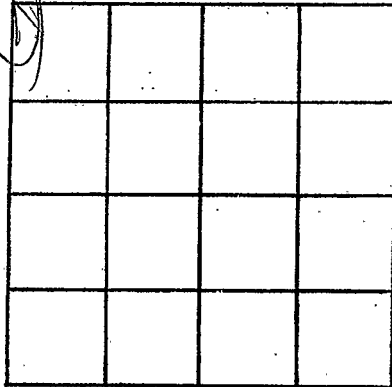

SECTION

24

Please indicate well location X.

ADDITIONAL INFORMATION

Lined area for additional information.

If more than one screen, show locations of each on sketch.