




If well telescopes please sketch and show depths.

GROUND LEVEL

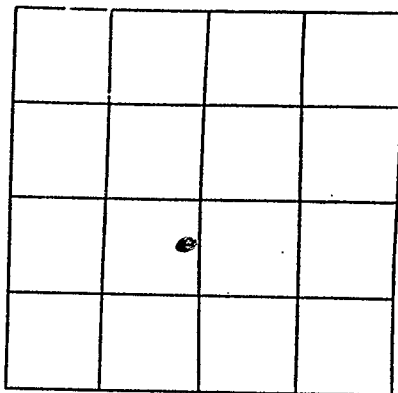

SECTION 255

Please indicate well location X.

Pump Capacity (GPM)	No. of Stages	Setting Depth
12	9	100 FT.

PUMP TEST

Well yielded 10 GPM with  
 a drawdown of \_\_\_\_\_ ft.  
 after \_\_\_\_\_ hours of pumping

LOG DATA

TYPE OF LOG RUN (Circle One): No Log Run  
 Electric, Gamma Ray, Density, Sonic, Neutron,  
 Other (Describe) \_\_\_\_\_

Name of Organization Running Log \_\_\_\_\_

GEOLOGIC DATA (Office Use Only)

Surface Elev.	Geologic Unit	Unit Thickness	Depth to Top
Subs. SWL	Date	Analysis	Aquifer Test

Driller's Remarks

3/4 hp - wing bladder  
draws extreme amount  
of water while  
mixed very heavy mud

If more than one screen,  
 show location of each on sketch.