

MISSISSIPPI
BOARD OF WATER COMMISSIONERS
416 North State Street
Jackson, Mississippi 39201

CODED

WATER WELL DRILLERS LOG

Marshall
E 1
7-15-68

7-15 1968 Harris Bros Marshall
date well completed firm name county well located

LANDOWNER David Lipton

Rto 2

Byhalia
(mailing address)

WELL LOCATION:

sec 29 T 2 N R 4 E
3 1/2 miles N of Byhalia
(distance) (direction) (nearest town)

WELL PURPOSE: none
(home, irrigation, municipal, industrial)

WELL COMPLETION DATA:

- (1) diameter (inches) 4"
- (2) total depth (feet) 100
- (3) static water level (feet) 100 ^{below} above top of ground.
- (4) casing Plastic 93'
(material) (depth)
4" if telescope see back.
(size)
- (5) screen 7' 93'
(length) (depth to top)
008 Plastic
(size) (material)
- (6) pump 3/4 7
(HP) (yield gpm)
elec
(type power)
- (7) electric log no
(yes or no)

(organization running log)

(8) how well bottom plugged weak
spot

description of formations encountered

from to

top soil	0	20
white clay	20	35
white clay + sand	35	85
Coarse sand	85	100

CODED


JAN 21 1969

MISS. BD. OF
WATER COMM.

DRILLERS REMARKS:

If well telescopes please sketch and show depths.

GROUND LEVEL

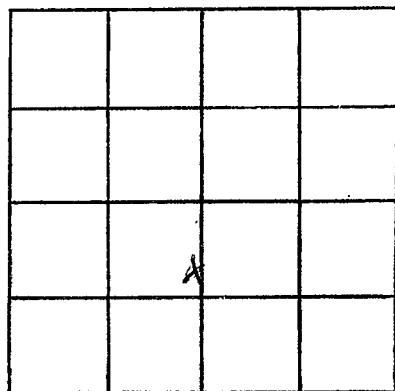

SECTION 29

Please indicate well location X.

ADDITIONAL INFORMATION

If more than one screen,
show locations of each on sketch.