

CODED

CODED

MISSISSIPPI BOARD OF WATER COMMISSIONERS
416 North State Street
Jackson, Mississippi 39201

Marshall
E2
10-15-68

WATER WELL DRILLERS LOG

10-15 1968 Harris Bros Marshall
date well completed firm name county well located

LANDOWNER: Curtis Howard
pto 2
Byhalia, Miss
(mailing address)

description of fomations encountered	from	to
top soil	0	20
clay + sand	20	60
fine sand	60	85
coarse sand	85	100

WELL LOCATION:
sec 8 T 2 N R 4 E
4 1/2 miles NE of Byhalia
(distance) (direction) (nearest town)

WELL PURPOSE: none
(home, irrigation, municipal, industrial)

- WELL COMPLETION DATA:
- (1) diameter (inches) 4"
 - (2) total depth (feet) 100
 - (3) static water level (feet) 40 ^{below} above top of ground.
 - (4) casing Plastic, 93
(material) (depth)
4" if telescope see back.
(size)
 - (5) screen 7', 93
(length) (depth to top)
.008, Plastic
(size) (material)
 - (6) pump 3/4, 7
(HP) (yield gpm)
elec
(type power)
 - (7) electric log no
(yes or no)

CODED

(organization running log)

(8) how well bottom plugged back
spot


DRILLERS REMARKS:

JAN 21 1969

MISS. BD. OF
WATER COMM.

If well telescopes please sketch and show depths.

GROUND LEVEL

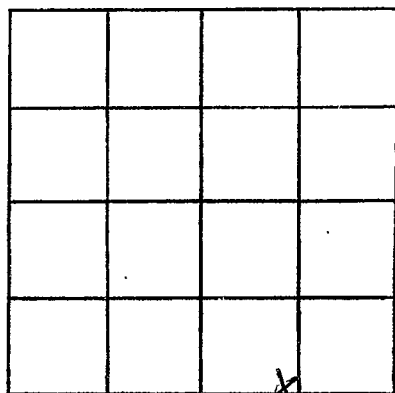

SECTION 8

Please indicate well location X.

ADDITIONAL INFORMATION

If more than one screen,
show locations of each on sketch.