

Marshall
 E4
 12-14-68

MISSISSIPPI
 BOARD OF WATER COMMISSIONERS
 416 North State Street
 Jackson, Mississippi 39201

CODED

CODED

WATER WELL DRILLERS LOG

12-14 1968 *Bob Smith* *Marshall*
 date well completed firm name county well located

LANDOWNER: *Roberson*
Victoria, Miss.
 (mailing address)
 WELL LOCATION:
 sec. *8* T. *2* N. R. *4* E
 (S) (E)
13 miles *N* of *West*
 (distance) (direction) (nearest town)

description of formations encountered	from	to
<i>red Clay</i>	<i>0</i>	<i>10</i>
<i>red sand</i>	<i>10</i>	<i>40</i>
<i>white Sand</i>	<i>40</i>	<i>160</i>

WELL PURPOSE: *None*
 (home, irrigation, municipal, industrial)

WELL COMPLETION DATA:
 (1) diameter (inches) *4*
 (2) total depth (feet) *160*
 (3) static water level (feet) *80* below above top of ground.
 (4) casing *0.625* *160*
 (material) (depth)
 (size) If telescope see back.
 (5) screen *20* *140*
 (length) (depth to top)
4 *0.625*
 (size) (material)
 (6) pump *1* *10*
 (HP) (yield gpm)
1 hp.
 (type power)
 (7) electric log *no*
 (yes or no)
 (organization running log)
 (8) how well bottom plugged *plugged*

CODED

CODED


FEB 19 1969

MISS. BD OF WATER COMMISSIONERS

DRILLERS REMARKS:
good drilling

If well telescopes please sketch and show depths.

GROUND LEVEL

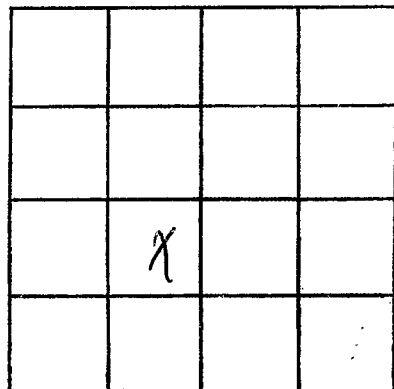

SECTION 8

Please indicate well location X.

ADDITIONAL INFORMATION

If more than one screen, show locations of each on sketch.