

Marshall
 Eb
 3-6-69

MISSISSIPPI
 BOARD OF WATER COMMISSIONERS
 416 North State Street
 Jackson, Mississippi 39201

CODED

WATER WELL DRILLERS LOG

3-6 1969 Atkinson & Frost Marshall
 date well completed firm name county well located

LANDOWNER: Thony Hardaway
Hardaway
Byhalia Miss.
 (mailing address)

description of formations encountered	from to	
	feet	feet
Red Clay	0	15
Red SAND	15	30
white Clay	30	80
Rock	80	82
white sand.	82	100

WELL LOCATION:
 sec. 3 T. 2 N. R. 4 E
2 1/2 miles N of Victoria
 (distance) (direction) (nearest town)

WELL PURPOSE: Home
 (home, irrigation, municipal, industrial)

WELL COMPLETION DATA:

- (1) diameter (inches) 4
- (2) total depth (feet) 140
- (3) static water level (feet) 100 below above top of ground.
- (4) casing P.V.C. 130
 (material) (depth)
 (size) If telescope see back.
- (5) screen 10 120
 (length) (depth to top)
4" P.V.C. rockwell
 (size) (material)
- (6) pump 1/2 10
 (HP) (yield gpm)
Elec.
 (type power)
- (7) electric log NO
 (yes or no)

(organization running log)

(8) how well bottom plugged 4" CAP.


DRILLERS REMARKS:

CODED

BOARD OF WATER COMMISSIONERS
 1-3-1969
 MISS. DIV. OF WATER CONTROL

If well telescopes please sketch and show depths.

GROUND LEVEL

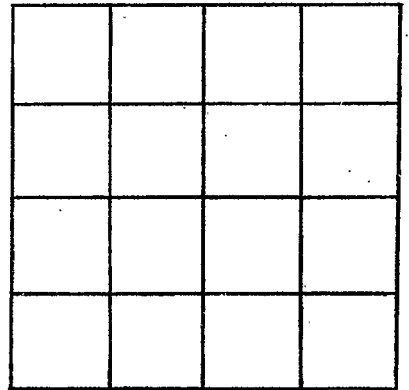

SECTION 3

Please indicate well location X.

ADDITIONAL INFORMATION

If more than one screen, show locations of each on sketch.