

CODED

MISSISSIPPI
BOARD OF WATER COMMISSIONERS
416 North State Street
Jackson, Mississippi 39201

CODED

WATER WELL DRILLERS LOG

Marshall
E 9
5-69

May 23 1969 Rimpasubee Co Marshall
date well completed firm name county well located

LANDOWNER:

Bill Smith
R# 2 Colherully Farm
(mailing address)

description of formations encountered

from to

Clay
Sand

0 60
60 130

WELL LOCATION:

sec. 10 T. 2 N. R. 4 E.
6 miles North of Victoria
(distance) (direction) (nearest town)

WELL PURPOSE:

(home, irrigation, municipal, industrial)

WELL COMPLETION DATA:

- (1) diameter (inches) 4"
- (2) total depth (feet) 130
- (3) static water level (feet) 100 below above top of ground.
- (4) casing 4" PVC 123
(material) (depth)
(size) If telescope see back.
- (5) screen 24" 123
(length) (depth to top)
4" gravel wall
(size) (material)
- (6) pump 3/4 10
(HP) (yield gpm)
(type power)

CODED

(7) electric log (yes or no)

(organization running log)

(8) how well bottom plugged 4" plug


MAY 1 1969

MISS. BD. OF
WATER COMMISSIONERS

DRILLERS REMARKS:

If well telescopes please sketch and show depths.

GROUND LEVEL

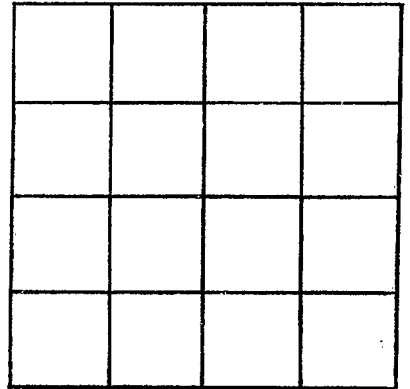

SECTION _____

Please indicate well location X.

ADDITIONAL INFORMATION

If more than one screen,
show locations of each on sketch.